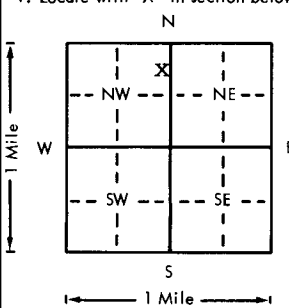
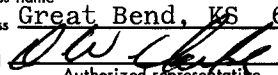


USE TYPEWRITER OR BALL POINT PEN—PRESS FIRMLY, PRINT CLEARLY.

WATER WELL RECORD
KSA 82a-1201-1215

Kansas Department of Health and Environment—Division of Environment
(Water well Contractors)
Topeka, Kansas 66620

1. Location of well:	County Edwards	Fraction E 1/2 XXX NE 1/4 NW 1/4	Section number 9	Township number T 25 S R 18	Range number EW
2. Distance and direction from nearest town or city: 6 1/4 miles Southeast of Kinsley, KS Street address of well location if in city:			3. Owner of well: Roy Lange R.R. or street: Route 2 - Box 16 City, state, zip code: XXX Lewis, KS 67552		
4. Locate with "X" in section below: 			Sketch map: 2600' East and 900' South of NW Corner Sec. 9		
5. Type and color of material			From	To	6. Bore hole dia. 9 in. Completion date 1/27/79 Well depth 71 ft.
Sandy top soil			0	3	7. <input checked="" type="checkbox"/> Cable tool <input checked="" type="checkbox"/> Rotary <input type="checkbox"/> Driven <input type="checkbox"/> Dug <input type="checkbox"/> Hollow rod <input type="checkbox"/> Jetted <input type="checkbox"/> Bored <input type="checkbox"/> Reverse rotary
Gray clay			3	15	8. Use: <input type="checkbox"/> Domestic <input type="checkbox"/> Public supply <input type="checkbox"/> Industry <input type="checkbox"/> Irrigation <input type="checkbox"/> Air conditioning <input checked="" type="checkbox"/> Stock <input type="checkbox"/> Lawn <input type="checkbox"/> Oil field water <input type="checkbox"/> Other
Sandy clay			15	21	9. Casing: Material Styrene <input checked="" type="checkbox"/> Above <input type="checkbox"/> or below Threaded <input type="checkbox"/> Welded <input checked="" type="checkbox"/> Surface 2' <input checked="" type="checkbox"/> RMP <input type="checkbox"/> PVC <input type="checkbox"/> Weight 1.5 lbs./ft. Dia. 5 in. to 51 ft. depth Wall Thickness: inches or Dia. <input type="checkbox"/> in. to <input type="checkbox"/> ft. depth gage No. 200
Fine sand & gravel			21	54	10. Screen: Manufacturer's name Jess & Lowell <input checked="" type="checkbox"/> Styrene 200 Dia. 5" <input checked="" type="checkbox"/> Slot gauze 1/8 hole Length 20' Set between 51 ft. and 71 ft. <input type="checkbox"/> ft. and <input type="checkbox"/> ft. Gravel pack? <input checked="" type="checkbox"/> Yes Size range of material 3/8-200
Sand & gravel			54	61	11. Static water level: 27' 6" ft. below land surface Date 1/27/79 mo./day/yr.
Coarse sand & gravel			61	71	12. Pumping level below land surfaces: N/C <input type="checkbox"/> ft. after <input type="checkbox"/> hrs. pumping <input type="checkbox"/> g.p.m. <input type="checkbox"/> ft. after <input type="checkbox"/> hrs. pumping <input type="checkbox"/> g.p.m. Estimated maximum yield <input type="checkbox"/> g.p.m.
					13. Water sample submitted: <input type="checkbox"/> Yes <input checked="" type="checkbox"/> No Date <input type="checkbox"/> mo./day/yr.
					14. Well head completion: <input type="checkbox"/> Pitless adapter <input type="checkbox"/> 12 Inches above grade
					15. Well grouted? <input checked="" type="checkbox"/> Yes With: <input checked="" type="checkbox"/> Neat cement <input type="checkbox"/> Bentonite <input type="checkbox"/> Concrete Depth: From 45 ft. to 71 ft.
					16. Nearest source of possible contamination: FIELD ft. <input type="checkbox"/> Direction <input type="checkbox"/> Type <input type="checkbox"/> Well disinfected upon completion? <input checked="" type="checkbox"/> Yes <input type="checkbox"/> No
					17. Pump: <input checked="" type="checkbox"/> Not installed Manufacturer's name <input type="checkbox"/> Model number <input type="checkbox"/> HP <input type="checkbox"/> Volts <input type="checkbox"/> Length of drop pipe <input type="checkbox"/> ft. capacity <input type="checkbox"/> g.p.m. Type: <input type="checkbox"/> Submersible <input type="checkbox"/> Turbine <input type="checkbox"/> Jet <input type="checkbox"/> Reciprocating <input type="checkbox"/> Centrifugal <input type="checkbox"/> Other
(Use a second sheet if needed)					
18. Elevation:	19. Remarks:		20. Water well contractor's certification: This well was drilled under my jurisdiction and this report is true to the best of my knowledge and belief. Clarke Well & Eq., Inc. 185 Business name License No. <input type="checkbox"/> Address Great Bend, KS 67530 Signed  Date 1-30-79 Authorized representative		
Topography: <input type="checkbox"/> Hill <input type="checkbox"/> Slope <input type="checkbox"/> Upland <input type="checkbox"/> Valley					

25-180-9 E 1/2 NE NW 1/4

Forward the white, blue and pink copies to the Department of Health and Environment

Form WWC-5