


1 LOCATION OF WATER WELL: County: Edwards Fraction: N 1/4 C 1/4 NW 1/4 Section Number: 10 Township Number: T 25 S Range Number: R 18 E/W

Distance and direction from nearest town or city street address of well if located within city?
3 south, 1 3/4 west of Lewis, Ks.

2 WATER WELL OWNER: Thomas Stade Jim McClaren
 RR#, St. Address, Box #: 16147 Tina Court Board of Agriculture, Division of Water Resources
 City, State, ZIP Code: Grass Valley Ca. 95949 Application Number: 9,455

3 LOCATE WELL'S LOCATION WITH AN "X" IN SECTION BOX:

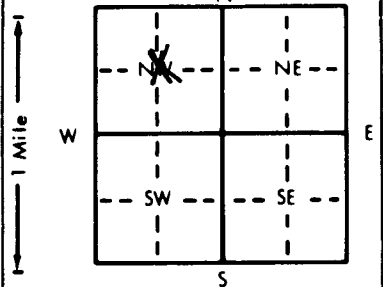

4 DEPTH OF COMPLETED WELL: 137 ft. ELEVATION:

Depth(s) Groundwater Encountered 1. ft. 2. ft. 3. ft.
 WELL'S STATIC WATER LEVEL 29 ft. below land surface measured on mo/day/yr 10-23-90
 Pump test data: Well water was ft. after hours pumping gpm
 Est. Yield 950 gpm: Well water was 73 ft. after 250x 3 hours pumping 950 gpm
 Bore Hole Diameter 26 in. to 137 ft., and in. to ft.
 WELL WATER TO BE USED AS: 5 Public water supply 8 Air conditioning 11 Injection well
 1 Domestic 3 Feedlot 6 Oil field water supply 9 Dewatering 12 Other (Specify below)
2 Irrigation 4 Industrial 7 Lawn and garden only 10 Monitoring well
 Was a chemical/bacteriological sample submitted to Department? Yes.....No.....x...; If yes, mo/day/yr sample was submitted
 Water Well Disinfected? Yes hth No

5 TYPE OF BLANK CASING USED: 5 Wrought iron 8 Concrete tile CASING JOINTS: Glued x Clamped
 1 Steel 3 RMP (SR) 6 Asbestos-Cement 9 Other (specify below) Welded
2 PVC 4 ABS 7 Fiberglass Threaded.....

Blank casing diameter 16 in. to 67 ft., Dia in. to ft., Dia in. to ft.
 Casing height above land surface 12 in., weight SDR 32.5 lbs./ft. Wall thickness or gauge No.

TYPE OF SCREEN OR PERFORATION MATERIAL: 7 PVC 10 Asbestos-cement
 1 Steel 3 Stainless steel 5 Fiberglass 8 RMP (SR) 11 Other (specify)
 2 Brass 4 Galvanized steel 6 Concrete tile 9 ABS 12 None used (open hole)

SCREEN OR PERFORATION OPENINGS ARE: 5 Gauzed wrapped 8 Saw cut 11 None (open hole)
1 Continuous slot 3 Mill slot 6 Wire wrapped 9 Drilled holes
 2 Louvered shutter 4 Key punched 7 Torch cut 10 Other (specify)

SCREEN-PERFORATED INTERVALS: From 67 ft. to 137 ft., From ft. to ft.
 From ft. to ft., From ft. to ft.
 GRAVEL PACK INTERVALS: From 21 ft. to 137 ft., From ft. to ft.
 From ft. to ft., From ft. to ft.

6 GROUT MATERIAL: 1 Neat cement 2 Cement grout 3 Bentonite 4 Other

Grout Intervals: From 0 ft. to 21 ft., From ft. to ft., From ft. to ft.
 What is the nearest source of possible contamination:
 1 Septic tank 4 Lateral lines 7 Pit privy 10 Livestock pens 14 Abandoned water well
 2 Sewer lines 5 Cess pool 8 Sewage lagoon 11 Fuel storage 15 Oil well/Gas well
 3 Watertight sewer lines 6 Seepage pit 9 Feedyard 12 Fertilizer storage 16 Other (specify below)
 13 Insecticide storage none

Direction from well? How many feet?

FROM	TO	LITHOLOGIC LOG	FROM	TO	PLUGGING INTERVALS
0	3	Sandy top soil			
3	13	Red clay			
13	27	Sand and gravel			
27	28	Clay			
28	54	Sand and gravel with streaks of clay			
54	54 1/2	Rock			
54 1/2	61	Clay with sand			
61	90	Sand and gravel			
90	96	Caly with sand			
96	101	Sand and gravel			
101	106	Sadand gravel with stringer of clay			
106	136	Sand and gravel			1
136	137	White brown clay			

7 CONTRACTOR'S OR LANDOWNER'S CERTIFICATION: This water well was (1) constructed, (2) reconstructed, or (3) plugged under my jurisdiction and was completed on (mo/day/year) 5-9-92 and this record is true to the best of my knowledge and belief. Kansas Water Well Contractor's License No. 134 This Water Well Record was completed on (mo/day/yr) 6-3-92 under the business name of Rosencrantz-Bemis by (signature) Freddie Hodson

INSTRUCTIONS: Use typewriter or ball point pen. PLEASE PRESS FIRMLY and PRINT clearly. Please fill in blanks, underline or circle the correct answers. Send top three copies to Kansas Department of Health and Environment, Bureau of Water, Topeka, Kansas 66620-0001. Telephone: 913-296-5545. Send one to WATER WELL OWNER and retain one for your records.

OFFICE USE ONLY
T
R
E/W
SEC.
1/4
1/4
1/4