


1 LOCATION OF WATER WELL: Fraction SE 1/4 SE 1/4 SW 1/4 Section Number 17 Township Number T 25 S Range Number R 18 EW

Distance and direction from nearest town or city street address of well if located within city?  
 Approx 3 mi south and 4 1/2 mi east of Kinsley

2 WATER WELL OWNER: Glenn Strawn  
 RR#, St. Address, Box #: Route 2  
 City, State, ZIP Code: Lewis, KS 67552  
 Board of Agriculture, Division of Water Resources  
 Application Number: not required

3 LOCATE WELL'S LOCATION WITH AN "X" IN SECTION BOX:

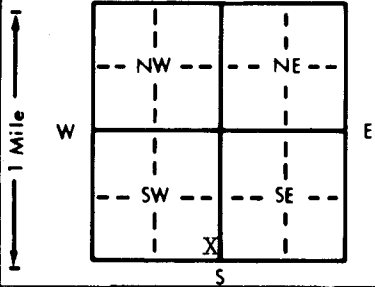

4 DEPTH OF COMPLETED WELL: 66.5 ft. ELEVATION: unknown  
 Depth(s) Groundwater Encountered 1. 36.5 ft. 2. ft. 3. ft.  
 WELL'S STATIC WATER LEVEL: 36.5 ft. below land surface measured on mo/day/yr 9-24-83  
 Pump test data: Well water was not ck'd ft. after hours pumping gpm  
 Est. Yield unknown gpm: Well water was ft. after hours pumping gpm  
 Bore Hole Diameter: 9 in. to 66.5 ft., and in. to ft.  
 WELL WATER TO BE USED AS:  
 5 Public water supply 8 Air conditioning 11 Injection well  
 1 Domestic 3 Feedlot 6 Oil field water supply 9 Dewatering 12 Other (Specify below)  
 2 Irrigation 4 Industrial 7 Lawn and garden only 10 Observation well  
 Was a chemical/bacteriological sample submitted to Department? Yes No X; If yes, mo/day/yr sample was submitted  
 Water Well Disinfected? Yes X No

5 TYPE OF BLANK CASING USED:  
 1 Steel 3 RMP (SR) 5 Wrought iron 8 Concrete tile CASING JOINTS: Glued XX Clamped  
 2 PVC 4 ABS 6 Asbestos-Cement 9 Other (specify below) Welded  
 7 Fiberglass Threaded

Blank casing diameter 5 in. to 46.5 ft., Dia. in. to ft., Dia. in. to ft.  
 Casing height above land surface: 24 in., weight 2.277 lbs./ft. Wall thickness or gauge No. 219

TYPE OF SCREEN OR PERFORATION MATERIAL:  
 1 Steel 3 Stainless steel 5 Fiberglass 7 PVC 10 Asbestos-cement  
 2 Brass 4 Galvanized steel 6 Concrete tile 8 RMP (SR) 11 Other (specify)  
 12 None used (open hole)

SCREEN OR PERFORATION OPENINGS ARE:  
 1 Continuous slot 3 Mill slot 5 Gauzed wrapped 8 Saw cut 11 None (open hole)  
 2 Louvered shutter 4 Key punched 6 Wire wrapped 9 Drilled holes  
 7 Torch cut 10 Other (specify)

SCREEN-PERFORATED INTERVALS: From 46.5 ft. to 66.5 ft., From ft. to ft.  
 From ft. to ft., From ft. to ft.

GRAVEL PACK INTERVALS: From 38 ft. to 67 ft., From ft. to ft.  
 ANNULAR FILL From 10 ft. to 28 ft., From ft. to ft.

6 GROUT MATERIAL: 1 Neat cement 2 Cement grout 3 Bentonite 4 Other  
 Grout Intervals: From 0 ft. to 10 ft., From 28 ft. to 38 ft., From ft. to ft.

What is the nearest source of possible contamination:  
 1 Septic tank 4 Lateral lines 7 Pit privy 10 Livestock pens 14 Abandoned water well  
 2 Sewer lines 5 Cess pool 8 Sewage lagoon 11 Fuel storage 15 Oil well/Gas well  
 3 Watertight sewer lines 6 Seepage pit 9 Feedyard 12 Fertilizer storage 16 Other (specify below)  
 13 Insecticide storage

Direction from well? Southwest How many feet? 75

FROM	TO	LITHOLOGIC LOG	FROM	TO	LITHOLOGIC LOG
0	6	Sandy topsoil			
6	19 04	Sandy clay & sand			
19	38 05	Sand			
38	45	Coarse sand & fine gravel			
45	63	Sand & gravel, med.			
63	69 17	Sand & gravel with clay streak			
		<del>XXXXXXXXXXXXXXXXXXXXXXXXXXXXXXXXXXXX</del>			

7 CONTRACTOR'S OR LANDOWNER'S CERTIFICATION: This water well was (1) constructed, (2) reconstructed, or (3) plugged under my jurisdiction and was completed on (mo/day/year) 9-24-83 and this record is true to the best of my knowledge and belief. Kansas Water Well Contractor's License No. 185 This Water Well Record was completed on (mo/day/yr) 10-15-83 under the business name of Clarke Well & Eq., Inc. by (signature) [Signature]

INSTRUCTIONS: Use typewriter or ball point pen, PLEASE PRESS FIRMLY and PRINT clearly. Please fill in blanks, underline or circle the correct answers. Send top three copies to Kansas Department of Health and Environment, Division of Environment, Environmental Geology Section, Topeka, KS 66620. Send one to WATER WELL OWNER and retain one for your records.

OFFICE USE ONLY  
 T  
 25 R  
 18  
 EW  
 SEC.  
 17  
 SE 1/4  
 SE 1/4  
 SW 1/4

D