


1 LOCATION OF WATER WELL: EDWARDS County: Fraction NW 1/4 NE 1/4 Section Number 20 Township Number T 25 S Range Number R 18 E/W

Distance and direction from nearest town or city street address of well if located within city?  
 3-N 2 1/2 W. OF CENTER VIEW, KS.

2 WATER WELL OWNER: DON FLETCHER  
 RR#, St. Address, Box #: RT. 2 BOX 25 Board of Agriculture, Division of Water Resources  
 City, State, ZIP Code: LEWIS, KS. 67552 Application Number:

3 LOCATE WELL'S LOCATION WITH AN "X" IN SECTION BOX:

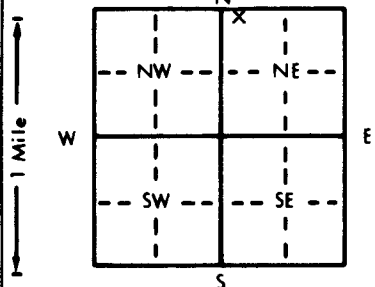

4 DEPTH OF COMPLETED WELL... 86 ft. ELEVATION:  
 Depth(s) Groundwater Encountered 1. ft. 2. ft. 3. ft.  
 WELL'S STATIC WATER LEVEL ... 42 to 6 ft. below land surface measured on mo/day/yr  
 Pump test data: Well water was ... ft. after ... hours pumping ... gpm  
 Est. Yield ... gpm: Well water was ... ft. after ... hours pumping ... gpm  
 Bore Hole Diameter ... 9 in. to ... ft., and ... in. to ... ft.  
 WELL WATER TO BE USED AS:  
 Domestic 3 Feedlot 6 Oil field water supply 9 Dewatering 12 Other (Specify below)  
 Irrigation 4 Industrial 7 Lawn and garden only 10 Monitoring well  
 Was a chemical/bacteriological sample submitted to Department? Yes.....No........; If yes, mo/day/yr sample was submitted  
 Water Well Disinfected? Yes  No

5 TYPE OF BLANK CASING USED:  
 1 Steel 3 RMP (SR) 5 Wrought iron 8 Concrete tile CASING JOINTS: Glued  Clamped  
 PVC 4 ABS 6 Asbestos-Cement 9 Other (specify below) Welded  
 7 Fiberglass Threaded

Blank casing diameter ... 5 in. to 76 ft., Dia ... in. to ... ft., Dia ... in. to ... ft.  
 Casing height above land surface ... 12 in., weight ... lbs./ft. Wall thickness or gauge No.

TYPE OF SCREEN OR PERFORATION MATERIAL:  
 7 PVC 10 Asbestos-cement  
 1 Steel 3 Stainless steel 5 Fiberglass 8 RMP (SR) 11 Other (specify)  
 2 Brass 4 Galvanized steel 6 Concrete tile 9 ABS 12 None used (open hole)

SCREEN OR PERFORATION OPENINGS ARE:  
 1 Continuous slot  Mill slot 5 Gauzed wrapped 8 Saw cut 11 None (open hole)  
 2 Louvered shutter 4 Key punched 6 Wire wrapped 9 Drilled holes  
 7 Torch cut 10 Other (specify)

SCREEN-PERFORATED INTERVALS: From ... 76 ft. to ... 86 ft., From ... ft. to ... ft.  
 GRAVEL PACK INTERVALS: From ... 23 ft. to ... 86 ft., From ... ft. to ... ft.

6 GROUT MATERIAL: 1 Neat cement 2 Cement grout  Bentonite 4 Other  
 Grout Intervals: From ... 3 ft. to ... 23 ft., From ... ft. to ... ft., From ... ft. to ... ft.

What is the nearest source of possible contamination:  
 1 Septic tank 4 Lateral lines 7 Pit privy 10 Livestock pens 14 Abandoned water well  
 2 Sewer lines 5 Cess pool 8 Sewage lagoon 11 Fuel storage 15 Oil well/Gas well  
 3 Watertight sewer lines 6 Seepage pit 9 Feedyard 12 Fertilizer storage 16 Other (specify below)  
 13 Insecticide storage NONE

Direction from well? How many feet?

FROM	TO	LITHOLOGIC LOG	FROM	TO	PLUGGING INTERVALS
0	3	TOP SOIL			
3	34	CLAY & SAND			
34	60	GRAVEL			
60	73	CLAY & GRAVEL			
73	86	GRAVEL			

7 CONTRACTOR'S OR LANDOWNER'S CERTIFICATION: This water well was (x) constructed, (2) reconstructed, or (3) plugged under my jurisdiction and was completed on (mo/day/year) 7-27-91 and this record is true to the best of my knowledge and belief. Kansas Water Well Contractor's License No. 462-B This Water Well Record was completed on (mo/day/yr) 11-32-91 under the business name of SAM'S WATER WELL SERVICE by (signature) Sara Rogers

OFFICE USE ONLY T R E/W SEC. 1/4 1/4 1/4