


WATER WELL RECORD Form WWC-5 KSA 82a-1212

1 LOCATION OF WATER WELL: Fraction Section Number Township Number Range Number  
 COUNTY: *Edwards* NE 1/4 SE 1/4 SE 1/4 24 T 25 S R 18 W

Distance and direction from nearest town or city street address of well if located within city?  
 5 1/2 S, OF LEWIS, KS

2 WATER WELL OWNER: MRS. ELMER HUFF EST 148  
 RR#, St. Address, Box #: Board of Agriculture, Division of Water Resources  
 City, State, ZIP code: LEWIS, KS - Application Number:

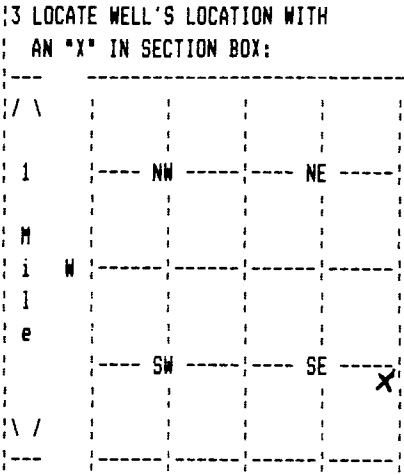

4 DEPTH OF COMPLETED WELL 45 ELEVATION:  
 Depth(s) Groundwater Encountered 1. 44 ft. 2. ft. 3. ft.  
 WELL'S STATIC WATER LEVEL 44 ft. below land surface measured on mo/day/yr  
 Pump test data: Well water was ft. after hours pumping gpm  
 Estimated Yield gpm: Well water was ft. after hours pumping gpm  
 Bore Hole Diameter 5 in. to 45 ft., and in. to ft.  
 WELL WATER TO BE USED AS: 01 DOMESTIC  
 Was a chemical/bacteriological sample submitted to department? No;  
 If yes, mo/day/yr sample was submitted Water well disinfected? Yes

5 TYPE OF BLANK CASING USED: 09 OTHER CASING JOINTS:  
 Blank casing diameter 0 in. to ft., Dia in. to ft., Dia in. to ft.  
 Casing height above land surface in., weight lbs/ft. Wall thickness or gauge No. 0  
 TYPE OF SCREEN OR PERFORATION MATERIAL: NONE USED  
 SCREEN OR PERFORATION OPENINGS ARE: 11 NONE (OPEN)

SCREEN PERFORATED INTERVALS: From ft. to ft., From ft. to ft.  
 GRAVEL PACK INTERVALS: From ft. to ft., From ft. to ft.  
 From ft. to ft., From ft. to ft.

6 GROUT MATERIAL 03 BENTONITE  
 Grout Intervals: From 6 ft. to 45 ft., From ft. to ft., From ft. to ft.  
 What is the nearest source of possible contamination: CATTLE PASTURE  
 Direction from well? ALL How many feet?

FROM	TO	LITHOLOGIC LOG	FROM	TO	PLUGGING INTERVALS
			6	45	HOLE PLUG

7 CONTRACTOR'S OR LANDOWNER'S CERTIFICATION: This water well was Plugged under my jurisdiction and was completed on (mo/day/year) 5 / 8 / 92 and this record is true to the best of my knowledge and belief. Kansas Water Well Contractor's License No. 224 This Water Well Record was completed on (mo/day/yr) 06/16/92 under the business name of CARL HAYSE WATER WELL SVC by (signature) *Carl Hayse*