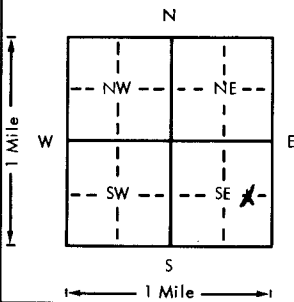


USE TYPEWRITER OR BALL POINT PEN-PRESS FIRMLY, PRINT CLEARLY.

WATER WELL RECORD
KSA 82a-1201-1215

Kansas Department of Health and Environment
Division of Environment
(Water well Contractors)
Topeka, Kansas 66620

1. Location of well:		County Edwards	Fraction C 1/4 E 1/4 SE 1/4	Section number 24	Township number T 25 S R 18 E W	Range number
2. Distance and direction from nearest town or city: 6 south of Lewis 1/2 W Street address of well location if in city:				3. Owner of well: Warren Hornbaker R.R. or street: Lewis, Ks. 67552 City, state, zip code:		
4. Locate with "X" in section below: Sketch map: 				6. Bore hole dia. 29 in. Completion date _____ Well depth 112 ft. 1-20-76		
5. Type and color of material				7. <input type="checkbox"/> Cable tool <input checked="" type="checkbox"/> Rotary <input type="checkbox"/> Driven <input type="checkbox"/> Dug <input type="checkbox"/> Hollow rod <input type="checkbox"/> Jetted <input type="checkbox"/> Bored <input type="checkbox"/> Reverse rotary		
				8. Use: <input type="checkbox"/> Domestic <input type="checkbox"/> Public supply <input type="checkbox"/> Industry <input checked="" type="checkbox"/> Irrigation <input type="checkbox"/> Air conditioning <input type="checkbox"/> Stock <input type="checkbox"/> Lawn <input type="checkbox"/> Oil field water <input type="checkbox"/> Other		
				9. Casing: Material Steel Weight: Above or below Threaded <input type="checkbox"/> Welded <input checked="" type="checkbox"/> Surface 12 in. RMP <input type="checkbox"/> PVC <input type="checkbox"/> Weight _____ lbs./ft. Dia. 16 in. to 112 ft. depth Wall Thickness: inches or Dia. _____ in. to _____ ft. depth gage No. 7		
				10. Screen: Manufacturer's name _____ Doerrs Type steel Dia. 16 Slot/gauge <input checked="" type="checkbox"/> 3/16 Length 40 Set between 72 ft. and 112 ft. _____ ft. and _____ ft. Gravel pack? <input checked="" type="checkbox"/> Size range of material 1/2-3/4-3/8		
				11. Static water level: _____ mo./day/yr. 36 ft. below land surface Date 12-15-75		
				12. Pumping level below land surfaces: _____ ft. after 1 hrs. pumping 800 g.p.m. _____ ft. after _____ hrs. pumping _____ g.p.m. Estimated maximum yield 1000 g.p.m.		
				13. Water sample submitted: _____ mo./day/yr. <input checked="" type="checkbox"/> Yes <input type="checkbox"/> No Date 12-15-75		
				14. Well head completion: <input type="checkbox"/> Pitless adapter _____ Inches above grade		
				15. Well grouted? <input checked="" type="checkbox"/> With: <input checked="" type="checkbox"/> Neat cement <input type="checkbox"/> Bentonite <input type="checkbox"/> Concrete Depth: From 0 ft. to 10 ft.		
				16. Nearest source of possible contamination: ft. 1000 Direction NE Type Feadyard Well disinfected upon completion? <input checked="" type="checkbox"/> Yes <input type="checkbox"/> No		
				17. Pump: _____ Not installed Manufacturer's name W.I.R. Model number 5-12cm-HP 60 Volts _____ Length of drop pipe 80 ft. capacity 800 g.p.m. Type: <input type="checkbox"/> Submersible <input checked="" type="checkbox"/> Turbine <input type="checkbox"/> Jet <input type="checkbox"/> Reciprocating <input type="checkbox"/> Centrifugal <input type="checkbox"/> Other		
				20. Water well contractor's certification: This well was drilled under my jurisdiction and this report is true to the best of my knowledge and belief. Rosenkrantz-Bemis 134 Business name _____ License No. _____ Address Great Bend, Ks. Signed J. Kilgore Date 6-19-76 Authorized representative		
18. Elevation:		19. Remarks:				
Topography: <input checked="" type="checkbox"/> Hill <input type="checkbox"/> Slope <input type="checkbox"/> Upland <input type="checkbox"/> Valley						

T 25 S 18 R 18 E W

Forward the white, blue and pink copies to the Department of Health and Environment

Form WWC-5