


1 LOCATION OF WATER WELL: County: Edwards Fraction NR. CTR. of the 1/4 1/4 NE 1/4 Section Number 28 Township Number T 25 S Range Number R 18 E/W

Distance and direction from nearest town or city street address of well if located within city?  
2 miles West-6miles South of Lewis Ks.

2 WATER WELL OWNER: J.D. Carroll  
 RR#, St. Address, Box # : 1718 W. Blanchard Board of Agriculture, Division of Water Resources  
 City, State, ZIP Code : So. Hutchinson, Ks. 67505 Application Number: 36989

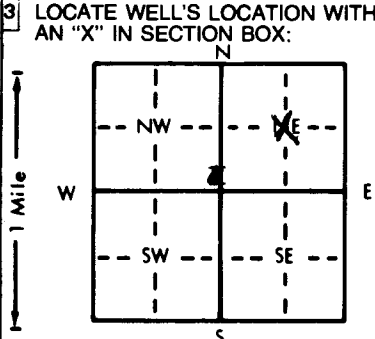

4 DEPTH OF COMPLETED WELL: 187 ft. ELEVATION: \_\_\_\_\_  
 Depth(s) Groundwater Encountered 1. \_\_\_\_\_ ft. 2. \_\_\_\_\_ ft. 3. \_\_\_\_\_ ft.  
 WELL'S STATIC WATER LEVEL: 34 ft. below land surface measured on mo/day/yr 2-27-92  
 Pump test data: Well water was \_\_\_\_\_ ft. after \_\_\_\_\_ hours pumping \_\_\_\_\_ gpm  
 Est. Yield \_\_\_\_\_ gpm: Well water was \_\_\_\_\_ ft. after \_\_\_\_\_ hours pumping \_\_\_\_\_ gpm  
 Bore Hole Diameter: 30 in. to \_\_\_\_\_ ft., and \_\_\_\_\_ in. to \_\_\_\_\_ ft.  
 WELL WATER TO BE USED AS: 5 Public water supply 8 Air conditioning 11 Injection well  
 1 Domestic 3 Feedlot 6 Oil field water supply 9 Dewatering 12 Other (Specify below)  
2 Irrigation 4 Industrial 7 Lawn and garden only 10 Monitoring well  
 Was a chemical/bacteriological sample submitted to Department? Yes \_\_\_\_\_ No X; If yes, mo/day/yr sample was submitted \_\_\_\_\_  
 Water Well Disinfected? Yes X No \_\_\_\_\_

5 TYPE OF BLANK CASING USED: 5 Wrought iron 8 Concrete tile CASING JOINTS: Glued X Clamped \_\_\_\_\_  
 1 Steel 3 RMP (SR) 6 Asbestos-Cement 9 Other (specify below) Welded \_\_\_\_\_  
2 PVC 4 ABS 7 Fiberglass \_\_\_\_\_ Threaded \_\_\_\_\_  
 Blank casing diameter: 16 in. to 147 ft. Dia \_\_\_\_\_ in. to \_\_\_\_\_ ft. Dia \_\_\_\_\_ in. to \_\_\_\_\_ ft.  
 Casing height above land surface: 24 in., weight \_\_\_\_\_ lbs./ft. Wall thickness or gauge No. FDR 32.5  
 TYPE OF SCREEN OR PERFORATION MATERIAL: 7 PVC 10 Asbestos-cement  
 1 Steel 3 Stainless steel 5 Fiberglass 8 RMP (SR) 11 Other (specify) \_\_\_\_\_  
 2 Brass 4 Galvanized steel 6 Concrete tile 9 ABS 12 None used (open hole)  
 SCREEN OR PERFORATION OPENINGS ARE: 5 Gauzed wrapped 8 Saw cut 11 None (open hole)  
 1 Continuous slot 3 Mill slot 6 Wire wrapped 9 Drilled holes  
 2 Louvered shutter 4 Key punched 7 Torch cut 10 Other (specify) \_\_\_\_\_  
 SCREEN-PERFORATED INTERVALS: From 187 ft. to 147 ft., From \_\_\_\_\_ ft. to \_\_\_\_\_ ft.  
 From \_\_\_\_\_ ft. to \_\_\_\_\_ ft., From \_\_\_\_\_ ft. to \_\_\_\_\_ ft.  
 GRAVEL PACK INTERVALS: From 130 ft. to 187 ft., From \_\_\_\_\_ ft. to \_\_\_\_\_ ft.  
 From 125 ft. to 20 ft., From \_\_\_\_\_ ft. to \_\_\_\_\_ ft.

6 GROUT MATERIAL: 1 Neat cement 2 Cement grout 3 Bentonite 4 Other ... & Hole Plug \_\_\_\_\_  
 Grout Intervals: From 0 ft. to 20 ft., From 130 ft. to 125 ft., From \_\_\_\_\_ ft. to \_\_\_\_\_ ft.  
 What is the nearest source of possible contamination: Hole Plug 10 Livestock pens 14 Abandoned water well  
 1 Septic tank 4 Lateral lines 7 Pit privy 11 Fuel storage 15 Oil well/Gas well  
 2 Sewer lines 5 Cess pool 8 Sewage lagoon 12 Fertilizer storage 16 Other (specify below)  
 3 Watertight sewer lines 6 Seepage pit 9 Feedyard 13 Insecticide storage \_\_\_\_\_ None \_\_\_\_\_

Direction from well? \_\_\_\_\_ How many feet? \_\_\_\_\_ Lithologic Log

FROM	TO	LITHOLOGIC LOG	FROM	TO	Lithologic Log PLUGGING INTERVALS
0	3	Top Soil	183	184	Cemented sand
3	10	Clay	184	187	sand & gravel
10	48	sand & gravel			
48	51	Clay			
51	66	Sand & Gravel			
66	76	Sandy clay			
76	91	Sand & gravel			
91	95	Gravel w/some Clay Streaks			
95	102	sand & gravel			
102	115	Fine sand & clay			
115	121	Gravel(big) & clay mixed			
121	130	Clay & fine sand			
130	135	sand & gravel (fine) mixed			
135	145	clay fine sand			
145	183	sand & gravel			

7 CONTRACTOR'S OR LANDOWNER'S CERTIFICATION: This water well was (1) constructed, (2) reconstructed, or (3) plugged under my jurisdiction and was completed on (mo/day/year) 2-27-92 and this record is true to the best of my knowledge and belief. Kansas  
 Water Well Contractor's License No. 134 This Water Well Record was completed on (mo/day/yr) 3-16-92  
 under the business name of Rosencrantz-Bemis by (signature) Dwight Dodson

INSTRUCTIONS: Use typewriter or ball point pen. PLEASE PRESS FIRMLY and PRINT clearly. Please fill in blanks, underline or circle the correct answers. Send top three copies to Kansas Department of Health and Environment, Bureau of Water Protection, Topeka, Kansas 66620-7320. Telephone: 913-296-5514. Send one to WATER WELL OWNER and retain one for your records.

OFFICE USE ONLY  
T  
R  
EW  
SEC.  
1/4  
1/4  
1/4