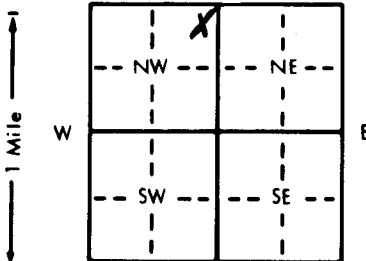


1 LOCATION OF WATER WELL:		Fraction		Section Number		Township Number		Range Number			
County: Edwards		ne 1/4 ne 1/4 nw 1/4		29		T 25 S		R 18 E/W			
Distance and direction from nearest town or city street address of well if located within city? 4 east and 4 1/2 south of Kinsley Kansas											
2 WATER WELL OWNER: Robert McLean RR#, St. Address, Box #: Lewis Kansas City, State, ZIP Code: _____ Board of Agriculture, Division of Water Resources Application Number: _____											
3 LOCATE WELL'S LOCATION WITH AN "X" IN SECTION BOX:				4 DEPTH OF COMPLETED WELL: 80 ft. ELEVATION: _____							
				Depth(s) Groundwater Encountered 1. 39 ft. 2. _____ ft. 3. _____ ft.							
				WELL'S STATIC WATER LEVEL 39 ft. below land surface measured on mo/day/yr 11/11/86							
				Pump test data: Well water was 39 ft. after 1 hours pumping 3 gpm							
				Est. Yield 20 gpm: Well water was _____ ft. after _____ hours pumping _____ gpm							
Bore Hole Diameter 8 3/4 in. to _____ ft. and _____ in. to _____ ft.				WELL WATER TO BE USED AS:							
X Domestic				3 Feedlot		6 Oil field water supply		9 Dewatering		12 Other (Specify below)	
2 Irrigation				4 Industrial		7 Lawn and garden only		10 Observation well			
Was a chemical/bacteriological sample submitted to Department? Yes _____ No X ; If yes, mo/day/yr sample was submitted _____ Water Well Disinfected? Yes X No _____											
5 TYPE OF BLANK CASING USED:											
1 Steel 3 RMP (SR) 5 Wrought iron 8 Concrete tile CASING JOINTS: Glued X Clamped _____											
X PVC 4 ABS 6 Asbestos-Cement 9 Other (specify below) Welded _____											
7 Fiberglass Threaded _____											
Blank casing diameter 5 in. to 60 ft., Dia. _____ in. to _____ ft., Dia. _____ in. to _____ ft.											
Casing height above land surface 24 in., weight SDR 26 lbs./ft. Wall thickness or gauge No. _____											
TYPE OF SCREEN OR PERFORATION MATERIAL:											
1 Steel 3 Stainless steel 5 Fiberglass X7 PVC 10 Asbestos-cement											
2 Brass 4 Galvanized steel 6 Concrete tile 9 ABS 11 Other (specify) _____											
12 None used (open hole)											
SCREEN OR PERFORATION OPENINGS ARE:											
1 Continuous slot 3 Mill slot 5 Gauzed wrapped X8 Saw cut 11 None (open hole)											
2 Louvered shutter 4 Key punched 6 Wire wrapped 9 Drilled holes											
7 Torch cut 10 Other (specify) _____											
SCREEN-PERFORATED INTERVALS: From 60 ft. to 80 ft., From _____ ft. to _____ ft.											
From _____ ft. to _____ ft., From _____ ft. to _____ ft.											
GRAVEL PACK INTERVALS: From 35 ft. to 80 ft., From _____ ft. to _____ ft.											
From _____ ft. to _____ ft., From _____ ft. to _____ ft.											
6 GROUT MATERIAL: X Neat cement 2 Cement grout 3 Bentonite 4 Other _____											
Grout Intervals: From 0 ft. to 10 ft., From _____ ft. to _____ ft., From _____ ft. to _____ ft.											
What is the nearest source of possible contamination:											
1 Septic tank 4 Lateral lines 7 Pit privy 10 Livestock pens 14 Abandoned water well											
2 Sewer lines 5 Cess pool 8 Sewage lagoon 11 Fuel storage 15 Oil well/Gas well											
3 Watertight sewer lines 6 Seepage pit 9 Feedyard 12 Fertilizer storage 16 Other (specify below)											
13 Insecticide storage Cattle on pasture											
Direction from well? All around How many feet? _____											
FROM TO LITHOLOGIC LOG FROM TO LITHOLOGIC LOG											
0 3 top soil											
3 11 gumbo											
11 18 gray clay											
18 26 gray clay with sand streaks											
26 80 gravel											
7 CONTRACTOR'S OR LANDOWNER'S CERTIFICATION: This water well was X1 constructed, (2) reconstructed, or (3) plugged under my jurisdiction and was completed on (mo/day/year) 11/11/86 and this record is true to the best of my knowledge and belief. Kansas Water Well Contractor's License No. 224 This Water Well Record was completed on (mo/day/yr) 11/5/87 under the business name of Carl Hayse Water Well Service by (signature) Carl Hayse											
INSTRUCTIONS: Use typewriter or ball point pen, PLEASE PRESS FIRMLY and PRINT clearly. Please fill in blanks, underline or circle the correct answers. Send top three copies to Kansas Department of Health and Environment, Division of Environment, Environmental Geology Section, Topeka, KS 66620. Send one to WATER WELL OWNER and retain one for your records.											