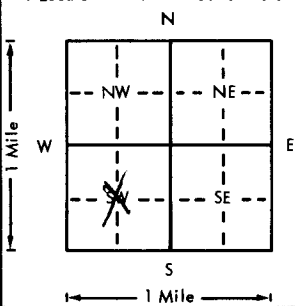


20 ✓

USE TYPEWRITER OR BALL POINT PEN-PRESS FIRMLY, PRINT CLEARLY.

WATER WELL RECORD
KSA 82a-1201-1215

Kansas Department of Health and Environment-Division of Environment (Water well Contractors) Topeka, Kansas 66620

1. Location of well:	County Edwards	Fraction 1/4 1/4 1/4	Section number 36	Township number T 25 S R 18	Range number 18
2. Distance and direction from nearest town or city: 7 1/2 S of Lewis 1/4 E 1/4 N			3. Owner of well: Robert Derley R.R. or street: City, state, zip code: Belprey Ks.		
4. Locate with "X" in section below: 			Sketch map:		
5. Type and color of material			From	To	6. Bore hole dia. 2 9/16 in. Completion date 4-15-76 Well depth 63 ft.
Sandy Top Soil			0	1 1/2	7. <input checked="" type="checkbox"/> Cable tool <input checked="" type="checkbox"/> Rotary <input type="checkbox"/> Driven <input type="checkbox"/> Dug <input type="checkbox"/> Hollow rod <input type="checkbox"/> Jetted <input type="checkbox"/> Bored <input type="checkbox"/> Reverse rotary
Clay			1 1/2	13	8. Use: <input type="checkbox"/> Domestic <input type="checkbox"/> Public supply <input type="checkbox"/> Industry <input checked="" type="checkbox"/> Irrigation <input type="checkbox"/> Air conditioning <input type="checkbox"/> Stock <input type="checkbox"/> Lawn <input type="checkbox"/> Oil field water <input type="checkbox"/> Other
Fine Sand			13	16	<input checked="" type="checkbox"/> Casing: Material steel Height: Above or below Threaded <input type="checkbox"/> Welded <input checked="" type="checkbox"/> Surface 18 in. RMP <input type="checkbox"/> PVC <input type="checkbox"/> Weight _____ lbs./ft. Dia. 1 1/2 in. to 63 ft. depth Wall Thickness: inches or Dia. _____ in. to _____ ft. depth gage No. 7
Good Gravel			16	41	10. Screen: Manufacturer's name Dacuss Type steel Dia. 1 1/2 1 1/2 gauge 3-16 Length 30 Set between 3.3 ft. and 63 ft. Gravel pack? <input checked="" type="checkbox"/> Size range of material 1/2 3/4 3/8
Clay			41	43	11. Static water level: _____ mo./day/yr. 12 ft. below land surface Date 1-23-76
Good Sand			43	59	12. Pumping level below land surfaces: 12 ft. after 1 1/2 hrs. pumping 1000 g.p.m. _____ ft. after _____ hrs. pumping _____ g.p.m. Estimated maximum yield 1200 g.p.m.
Extra good coarse Gravel			59	67	13. Water sample submitted: _____ mo./day/yr. <input checked="" type="checkbox"/> Yes <input type="checkbox"/> No Date 1-23-76
HARD Clay			67		14. Well head completion: <input type="checkbox"/> Pitless adapter _____ inches above grade
					15. Well grouted? <input checked="" type="checkbox"/> With: <input type="checkbox"/> Neat cement <input type="checkbox"/> Bentonite <input checked="" type="checkbox"/> Concrete Depth: From 0 ft. to 10 ft.
					16. Nearest source of possible contamination: ft. 314 Direction NW Type Corral Well disinfected upon completion? <input type="checkbox"/> Yes <input type="checkbox"/> No
					17. Pump: <input type="checkbox"/> Not installed Manufacturer's name WLR Model number 3:MS-12 HP 80 Volts _____ Length of drop pipe 50 ft. capacity 1000 g.p.m. Type: <input type="checkbox"/> Submersible <input checked="" type="checkbox"/> Turbine <input type="checkbox"/> Jet <input type="checkbox"/> Reciprocating <input type="checkbox"/> Centrifugal <input type="checkbox"/> Other
					(Use a second sheet if needed)
18. Elevation: 2147'	19. Remarks:		20. Water well contractor's certification: This well was drilled under my jurisdiction and this report is true to the best of my knowledge and belief. Rosenkrantz - Bern's 134 Business name _____ License No. _____ Address Great Bendy Ks. Signed Media Dodson Date 9/29/76 Authorized representative		

T 25 S R 18 E Sec 36 1/4 1/4 C 5 W

Forward the white, blue and pink copies to the Department of Health and Environment

Form WWC-5