

CORRECTION(S) TO WATER WELL RECORD (WWC-5)

(to rectify lacking or incorrect information)

County: Edwards

Location listed as:

Location changed to:

Section-Township-Range: 31-25S-17W

31-25S-18W

Fraction ($\frac{1}{4}$ $\frac{1}{4}$ $\frac{1}{4}$): NE SW SE

E2 W2 SE

Other changes: Initial statements: _____

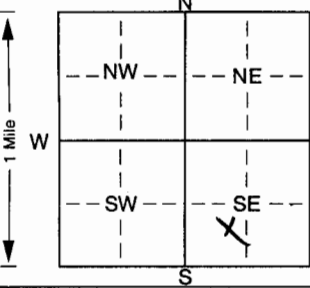
Changed to: _____

Comments: _____

verification method: Written & legal descriptions, and mapping tools
& aerial photos on KGS website, and other wells for
same owner in this section. initials: DRB date: 10/29/2010

submitted by: Kansas Geological Survey, Data Resources Library, 1930 Constant Ave., Lawrence, KS 66047-3726
to: Kansas Dept of Health & Environment, Bureau of Water, 1000 SW Jackson, Suite 420, Topeka, KS 66612-1367.

WATER WELL RECORD Form WWC-5 KSA 82a-1212 ID No.

1 LOCATION OF WATER WELL: County: Edwards		Fraction NE ¼ SW ¼ SE ¼	Section Number 31	Township Number T 25 S	Range Number R 17 E/W	
Distance and direction from nearest town or city street address of well if located within city? 1 ½ north, 2 west of Centerview, Ks	
2 WATER WELL OWNER: Turner Farms LLP RR#, St. Address, Box # : PO Box 460 City, State, ZIP Code : Great Bend, Ks. 67530 Board of Agriculture, Division of Water Resources Application Number: 35,362	
3 LOCATE WELL'S LOCATION WITH AN "X" IN SECTION BOX: <div style="text-align: center;"></div>		4 DEPTH OF COMPLETED WELL: 156 ft. ELEVATION: Depth(s) Groundwater Encountered: 30 ft. 1. 74 ft. 2. 700 ft. 3. 23-01 ft. WELL'S STATIC WATER LEVEL: 30 ft. below land surface measured on mo/day/yr Pump test data: Well water was 900 gpm: Well water was 76 ½ ft. after 4 hours pumping 900 gpm Est. Yield 900 gpm: Well water was 76 ½ ft. after 4 hours pumping 900 gpm Bore Hole Diameter: 28 in. to 155 ft., and 155 in. to 156 ft. WELL WATER TO BE USED AS: 5 Public water supply 8 Air conditioning 11 Injection well 1 Domestic 3 Feedlot 6 Oil field water supply 9 Dewatering 12 Other (Specify below) - 2 Irrigation - 4 Industrial 7 Domestic (lawn & garden) 10 Monitoring well Was a chemical/bacteriological sample submitted to Department? Yes. <input type="checkbox"/> No. <input checked="" type="checkbox"/> If yes, mo/day/yr sample was submitted <input type="checkbox"/> Yes <input checked="" type="checkbox"/> No	
5 TYPE OF BLANK CASING USED: 1 Steel 3 RMP (SR) 5 Wrought iron 8 Concrete tile CASING JOINTS: Glued. <input checked="" type="checkbox"/> Clamped. <input type="checkbox"/> 2 PVC 4 ABS 6 Asbestos-Cement 9 Other (specify below) Welded <input type="checkbox"/> Blank casing diameter 16 in. to 76 ft., Dia 16 in. to 96-116 ft., Dia 116 in. to 156 ft. Casing height above land surface 12 in., weight Sch 40 lbs./ft. Wall thickness or gauge No. 116 TYPE OF SCREEN OR PERFORATION MATERIAL: 2 PVC 10 Asbestos-cement 1 Steel 3 Stainless steel 5 Fiberglass 8 RMP (SR) 11 Other (specify) <input type="checkbox"/> 2 Brass 4 Galvanized steel 6 Concrete tile 9 ABS 12 None used (open hole) SCREEN OR PERFORATION OPENINGS ARE: 5 Gauzed wrapped 8 Saw cut 11 None (open hole) 4 Continuous slot 3 Mill slot 6 Wire wrapped 9 Drilled holes 2 Louvered shutter 4 Key punched 7 Torch cut 10 Other (specify) 156 ft. SCREEN-PERFORATED INTERVALS: From 76 ft. to 96 ft., From 116 ft. to 156 ft. GRAVEL PACK INTERVALS: From 155 ft. to 20 ft., From 116 ft. to 156 ft. From 155 ft. to 20 ft., From 116 ft. to 156 ft.	
6 GROUT MATERIAL: 1 Neat cement 2 Cement grout 3 Bentonite 4 Other hole plug Grout Intervals: From 20 ft. to 0 ft., From 0 ft. to 156 ft. What is the nearest source of possible contamination: 1 Septic tank 4 Lateral lines 7 Pit privy 10 Livestock pens 14 Abandoned water well 2 Sewer lines 5 Cess pool 8 Sewage lagoon 11 Fuel storage 15 Oil well/Gas well 3 Watertight sewer lines 6 Seepage pit 9 Feedyard 12 Fertilizer storage 16 Other (specify below) Direction from well? west How many feet? 285'	
<table border="1" style="width:100%; border-collapse: collapse;"><thead><tr><th>FROM</th><th>TO</th><th>LITHOLOGIC LOG</th><th>FROM</th><th>TO</th><th>PLUGGING INTERVALS</th></tr></thead><tbody><tr><td>0</td><td>3</td><td>Top soil</td><td></td><td></td><td></td></tr><tr><td>3</td><td>10</td><td>Brown clay</td><td></td><td></td><td></td></tr><tr><td>10</td><td>20</td><td>Gray & brown sandy clay</td><td></td><td></td><td></td></tr><tr><td>20</td><td>47</td><td>Sand & gravel clean, coarse, loose</td><td></td><td></td><td></td></tr><tr><td>47</td><td>51</td><td>Brown clay sand mixed</td><td></td><td></td><td></td></tr><tr><td>51</td><td>65</td><td>Sand & gravel clean medium & loose</td><td></td><td></td><td></td></tr><tr><td>65</td><td>78</td><td>Brown, white & gray clay</td><td></td><td></td><td></td></tr><tr><td>78</td><td>92</td><td>Sand & gravel clean, medium & loose</td><td></td><td></td><td></td></tr><tr><td>92</td><td>95</td><td>Fine sand</td><td></td><td></td><td></td></tr><tr><td>95</td><td>108</td><td>Sand and gravel clean, medium, loose</td><td></td><td></td><td></td></tr><tr><td>108</td><td>133</td><td>Brown & white clay</td><td></td><td></td><td></td></tr><tr><td>133</td><td>155</td><td>Sand & gravel clean, medium & loose</td><td></td><td></td><td></td></tr><tr><td></td><td></td><td></td><td></td><td></td><td></td></tr><tr><td></td><td></td><td></td><td></td><td></td><td></td></tr>
7 CONTRACTOR'S OR LANDOWNER'S CERTIFICATION: This water well was (1) constructed , (2) reconstructed , or (3) plugged under my jurisdiction and was completed on (mo/day/year) 4-24-01 and this record is true to the best of my knowledge and belief. Kansas Water Well Contractor's Licence No. 134 This Water Well Record was completed on (mo/day/yr) 4-26-01 under the business name of Rosencrantz-Bemis by (signature) <i>Martin Dodson</i>	
INSTRUCTIONS: Use typewriter or ball point pen. PLEASE PRESS FIRMLY and PRINT clearly. Please fill in blanks, underline or circle the correct answers. Send top three copies to Kansas Department of Health and Environment, Bureau of Water, Topeka, Kansas 66620-0001. Telephone 785-296-5524. Send one to WATER WELL OWNER and retain one for your records. Fee of \$5.00 for each constructed well.	