

WATER WELL PLUGGING RECORD Form WWC-5P KSA 82a-1212 ID NO.


1 LOCATION OF WATER WELL: County: Edwards	Fraction $\frac{1}{4}$ NW $\frac{1}{4}$ SW $\frac{1}{4}$ SE $\frac{1}{4}$	Section Number 19	Township Number T 28 S	Range Number 18 <input type="checkbox"/> E <input checked="" type="checkbox"/> W
--	--	-----------------------------	----------------------------------	--

Street/Rural Address of Well Location; if unknown, distance & direction from nearest town or intersection: If at owner's address, check here

1/2N, 3 1/2W, 2N of Centerview, KS

2 WATER WELL OWNER: Jonelia Holloman
RR#, St. Address, Box #: **3865 Winters Hill Drive**
City, State ZIP Code: **Atlanta, GA 30360**

Global Positioning Systems (GPS) information:
Latitude: _____ (in decimal degrees)
Longitude: _____ (in decimal degrees)
Elevation: _____
Datum: WGS84, NAD83, NAD27
Collection Method:
 GPS unit (Make/Model: _____)
 Digital Map/Photo, Topographic Map, Land Survey
Est. Accuracy: < 3 m, 3-5 m, 5-15 m, > 15 m

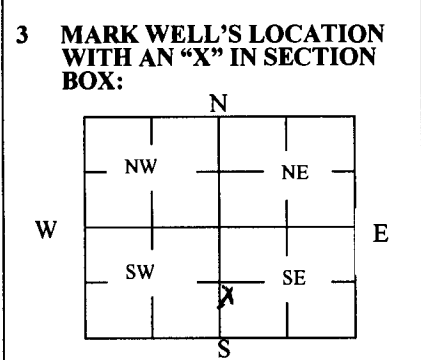

4 DEPTH OF WELL 104 **ft.**
WELL'S STATIC WATER LEVEL 43 **ft**
WELL WAS USED AS:
 Domestic Public Water Supply Dewatering
 Irrigation Oil Field Water Supply Monitoring
 Feedlot Domestic (Lawn & Garden) Injection Well
 Industrial Air Conditioning Other _____
Was a chemical/bacteriological sample submitted to Department? Yes No

5 TYPE OF BLANK CASING USED:
 Steel RMP (SR) Wrought Fiberglass Other (Specify below) _____
 PVC ABS Asbestos-Cement Concrete Tile
Blank casing diameter 5 in. Was casing pulled? Yes No If yes, how much _____
Casing height above or below land surface 3 ft. below in.

6 GROUT PLUG MATERIAL: Neat cement Cement grout Bentonite Other _____
Grout Plug Intervals: From 3 ft. to 84 ft., From _____ ft. to _____ ft., From _____ to _____ ft.
What is the nearest source of possible contamination:
 Septic tank Seepage pit Fuel Storage Other (specify below) _____
 Sewer lines Pit privy Fertilizer storage _____
 Watertight sewer lines Sewage lagoon Insecticide storage _____
 Lateral lines Feedyard Abandoned water well Direction from well? South
 Cess pool Livestock pens Oil well/Gas well How many feet? 110

FROM	TO	PLUGGING MATERIALS	FROM	TO	PLUGGING MATERIALS
104	84	gravel			Holloman
84	3	bentonite			
3	0	top soil			Sterling Drilling Company
					PO Box 1006
					Pratt, KS 67124

7 CONTRACTOR'S OR LANDOWNER'S CERTIFICATION: This water well was plugged under my jurisdiction and was completed on (mo/day/year) 12/30/10 and this record is true to the best of my knowledge and belief. Kansas Water Well Contractor's License No. 186. This Water Well Record was completed on (mo/day/year) 01/07/11 under the business name of Kelly's Water Well Service, Inc. by (signature) Kathum L. Stod

INSTRUCTIONS: Use typewriter or ballpoint pen. Please press firmly and print clearly. Please fill in blanks, underline or circle the correct answers. Send top three copies to Kansas Department of Health and Environment, Bureau of Water, Geology Section, 1000 SW Jackson St., Ste. 420, Topeka, Kansas 66612-1367. Telephone: 785/296-5524. Send one to Water Well Owner and retain one for your records. Visit us at <http://www.kdheks.gov/waterwell/index.html>.

Check one: White Copy Blue Copy Pink Copy