


WATER WELL RECORD

Form WWC-5

Division of Water Resources App. No.

1 LOCATION OF WATER WELL: County: Edwards	Fraction 1/4 SW 1/4 NW 1/4 NW 1/4	Section Number 6	Township No. T 25 S	Range Number R 18 <input type="checkbox"/> E <input checked="" type="checkbox"/> W
Street/Rural Address of Well Location; if unknown, distance & direction from nearest town or intersection: If at owner's address, check here <input type="checkbox"/> Approximately 1 mile south and 3.50 miles east of Kinsley.		Global Positioning System (GPS) information: Latitude: 37.909596 (in decimal degrees) Longitude: -99.350238 (in decimal degrees) Elevation: Unknown Datum: <input type="checkbox"/> WGS 84, <input checked="" type="checkbox"/> NAD 83, <input type="checkbox"/> NAD 27 Collection Method: <input checked="" type="checkbox"/> GPS unit (Make/Model: WAAS) <input type="checkbox"/> Digital Map/Photo, <input type="checkbox"/> Topographic Map, <input type="checkbox"/> Land Survey Est. Accuracy: <input type="checkbox"/> <3 m, <input checked="" type="checkbox"/> 3-5 m, <input type="checkbox"/> 5-15 m, <input type="checkbox"/> >15 m		

2 WATER WELL OWNER: **City of Kinsley**
RR#, Street Address, Box #: **721 Marsh**
City, State, ZIP Code : **Kinsley, KS 67547**

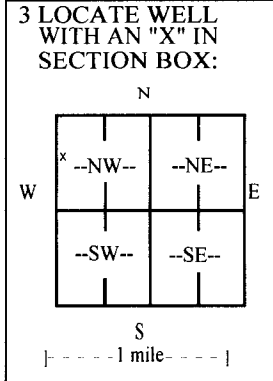

4 DEPTH OF COMPLETED WELL **94** ft.

Depth(s) Groundwater Encountered (1) _____ ft. (2) _____ ft. (3) _____ ft.
WELL'S STATIC WATER LEVEL **51** ft. below land surface measured on mo/day/yr **01/23/13**

Pump test data: Well water was **not checked** ft. after _____ hours pumping _____ gpm
EST. YIELD _____ gpm. Well water was _____ ft. after _____ hours pumping _____ gpm

Bore Hole Diameter **36** in. to **94** ft., and _____ in. to _____ ft.

WELL WATER TO BE USED AS: Public water supply Geothermal Injection well
 Domestic Feedlot Oil field water supply Dewatering Other (Specify below)
 Irrigation Industrial Domestic-lawn & garden Monitoring well

Was a chemical/bacteriological sample submitted to Department? Yes No
If yes, mo/day/yr sample was submitted _____

Water well disinfected? Yes No

5 TYPE OF CASING USED: Steel PVC Other _____

CASING JOINTS: Glued Clamped Welded Threaded

Casing diameter **16** in. to **72** ft., Diameter _____ in. to _____ ft., Diameter _____ in. to _____ ft.
Casing height above land surface **24** in., Weight **62.58** lbs./ft., Wall thickness or gauge No. **.375**

TYPE OF SCREEN OR PERFORATION MATERIAL:
 Steel Stainless Steel PVC Other (Specify) _____
 Brass Galvanized Steel None used (open hole)

SCREEN OR PERFORATION OPENINGS ARE:
 Continuous slot Mill slot Gauze wrapped Torch cut Drilled holes None (open hole)
 Louvered shutter Key punched Wire wrapped Saw cut Other (specify) _____

SCREEN-PERFORATED INTERVALS: From **72** ft. to **92** ft., From _____ ft. to _____ ft.
From _____ ft. to _____ ft., From _____ ft. to _____ ft.

GRAVEL PACK INTERVALS: From **30** ft. to **94** ft., From _____ ft. to _____ ft.
From _____ ft. to _____ ft., From _____ ft. to _____ ft.

6 GROUT MATERIAL: Neat cement Cement grout Bentonite Other _____

Grout Intervals: From **0** ft. to **20** ft., From **20** ft. to **30** ft., From _____ ft. to _____ ft.

What is the nearest source of possible contamination:
 Septic tank Lateral lines Pit privy Livestock pens Insecticide storage Other (specify below)
 Sewer lines Cesspool Sewage lagoon Fuel storage Abandoned water well
 Watertight sewer lines Seepage pit Feedyard Fertilizer storage Oil well/gas well **None Known**

Direction from well _____ Distance from well _____

FROM	TO	LITHOLOGIC LOG	FROM	TO	LITHO. LOG (cont.) or PLUGGING INTERVALS
0	16	Sand, fine	66	67	Clay, gray
16	20	Clay, brown, sandy	67	80	Sand, gravel, fine to coarse
20	26	Sand, fine	80	87	Sand, gravel, fine to coarse, yellow clay streak
26	31	Clay, brown, sandy	87	92	Sandstone, coarse, medium, tight
31	35	Clay, gray, sandy	92	94	Clay, brown, white
35	40	Sand, fine to coarse			
40	52	Sand, gravel, fine to coarse			
52	55	Sand, gravel, fine to coarse, yellow clay streaks			
55	66	Sand, gravel, fine			

7 CONTRACTOR'S OR LANDOWNER'S CERTIFICATION: This water well was constructed, reconstructed, or plugged under my jurisdiction and was completed on (mo/day/year) **01/23/13** and this record is true to the best of my knowledge and belief.
Kansas Water Well Contractor's License No. **185** This Water Well Record was completed on (mo/day/year) **01/25/13**
under the business name of **Clarke Well & Equipment, Inc.** by (signature) _____

INSTRUCTIONS: Use typewriter or ball point pen. PLEASE PRESS FIRMLY and PRINT clearly. Please fill in blanks and check the correct answers. Send three copies (white, blue, pink) to Kansas Department of Health and Environment, Bureau of Water, Geology Section, 1000 SW Jackson St., Suite 420, Topeka, Kansas 66612-1367. Telephone 785-296-5522. Send one copy to WATER WELL OWNER and retain one for your records. Include fee of \$5.00 for each constructed well. Visit us at <http://www.kdheks.gov/waterwell/index.html>.