

WATER WELL RECORD

Form WWC-5

Division of Water Resources App. No.


26794

1 LOCATION OF WATER WELL: County: <u>Edwards</u>	Fraction <u>1/4</u> <u>1/4</u> NC <u>1/4</u> NW <u>1/4</u>	Section Number <u>27</u>	Township No. T <u>25</u> S	Range Number R <u>18</u> <input type="checkbox"/> E <input checked="" type="checkbox"/> W
--	---	-----------------------------	-------------------------------	--

Street/Rural Address of Well Location; if unknown, distance & direction from nearest town or intersection: If at owner's address, check here
2 North, 1 1/4 West of Centerview

Global Positioning System (GPS) information:
Latitude: 37.85080 (in decimal degrees)
Longitude: 099.29108 (in decimal degrees)
Elevation: 2143
Datum: WGS 84, NAD 83, NAD 27
Collection Method:
 GPS unit (Make/Model:)
 Digital Map/Photo, Topographic Map, Land Survey
Est. Accuracy: <3 m, 3-5 m, 5-15 m, >15 m

2 WATER WELL OWNER: Jean B. Martin Trust
RR#, Street Address, Box #: PO Box 181
City, State, ZIP Code : Oberlin, KS 67749

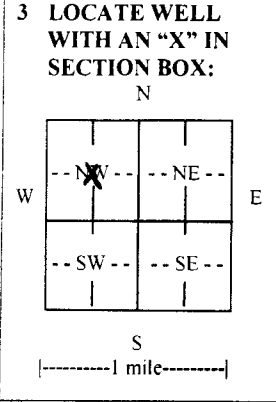

4 DEPTH OF COMPLETED WELL 178 ft.

Depth(s) Groundwater Encountered (1)..... ft. (2)..... ft. (3)..... ft.

WELL'S STATIC WATER LEVEL 51 ft. below land surface measured on mo/day/yr. 2-11-15

Pump test data: Well water was 81 ft. after 3 hours pumping. 847 gpm
EST. YIELD. 854 gpm. Well water was 82 ft. after 3 1/2 hours pumping. 854 gpm
Bore Hole Diameter 30 in. to 178 ft., and in. to ft.

WELL WATER TO BE USED AS: Public water supply Geothermal Injection well
 Domestic Feedlot Oil field water supply Dewatering Other (Specify below)
 Irrigation Industrial Domestic-lawn & garden Monitoring well

Was a chemical/bacteriological sample submitted to Department? Yes No
If yes, mo/day/yr sample was submitted.....

Water well disinfected? Yes No

5 TYPE OF CASING USED: Steel PVC Other

CASING JOINTS: Glued Clamped Welded Threaded
Casing diameter 16 in. to 178 ft., Diameter in. to ft., Diameter in. to ft.
Casing height above land surface 18 in., Weight Sch 40 lbs./ft., Wall thickness or gauge No.

TYPE OF SCREEN OR PERFORATION MATERIAL:
 Steel Stainless Steel PVC Other (Specify)
 Brass Galvanized Steel None used (open hole)

SCREEN OR PERFORATION OPENINGS ARE:
 Continuous slot Mill slot Gauze wrapped Torch cut Drilled holes None (open hole)
 Louvered shutter Key punched Wire wrapped Saw cut Other (specify)

SCREEN-PERFORATED INTERVALS: From 178 ft. to 138 ft., From ft. to ft.
From 96 ft. to 76 ft., From ft. to ft.

GRAVEL PACK INTERVALS: From 178 ft. to 20 ft., From ft. to ft.
From ft. to ft., From ft. to ft.

6 GROUT MATERIAL: Neat cement Cement grout Bentonite Other

Grout Intervals: From ft. to ft., From 20 ft. to 0 ft., From ft. to ft.

What is the nearest source of possible contamination:
 Septic tank Lateral lines Pit privy Livestock pens Insecticide storage Other (specify below)
 Sewer lines Cesspool Sewage lagoon Fuel storage Abandoned water well
 Watertight sewer lines Seepage pit Feedyard Fertilizer storage Oil well/gas well

Direction from well Distance from well

FROM	TO	LITHOLOGIC LOG	FROM	TO	LITHO. LOG (cont.) or PLUGGING INTERVALS
0	5	Sandy top soil & clay	158	161	Sandy tan clay
5	17	Fine sand & sandy clay	161	169	Sand & gravel- small
17	45	Sand & gravel- med, coarse	169	177	Sandy tan clay
45	54	Tan clay	177	178	Sandy clay & gravel
54	86	Sand & gravel- med, loose			
86	88	Gray clay			
88	98	Fine sand w/ clay pieces			
98	140	Tan clay & caliche			
140	158	Sand & gravel- small to med w/ few small clay pieces			

7 CONTRACTOR'S OR LANDOWNER'S CERTIFICATION: This water well was constructed, reconstructed, or plugged under my jurisdiction and was completed on (mo/day/year) 3-30-15 and this record is true to the best of my knowledge and belief. Kansas Water Well Contractor's License No. 134. This Water Well Record was completed on (mo/day/year) 4-2-15 under the business name of Rosencrantz- Bemis Ent Inc by (signature) Jon Alape

INSTRUCTIONS: Use typewriter or ball point pen. PLEASE PRESS FIRMLY and PRINT clearly. Please fill in blanks and check the correct answers. Send one copy to Kansas Department of Health and Environment, Bureau of Water, Geology Section, 1000 SW Jackson St., Suite 420. Topeka, Kansas 66612-1367. Telephone 785-296-5524. Send one copy to WATER WELL OWNER and retain one for your records. Include fee of \$5.00 for each constructed well. Visit us at <http://www.kdheks.gov/waterwell/index.html>