


WATER WELL RECORD Form WWC-5 KSA 82a-1212

1 LOCATION OF WATER WELL: Fraction NW 1/4 SE 1/4 SE 1/4 Section Number 23 Township Number T 25 S Range Number R 19 **EW**
 COUNTY: EDWARDS

Distance and direction from nearest town or city street address of well if located within city?
 FROM KINSLEY - 4 SOUTH ON HIGHWAY 183 - 3/4 EAST & 1/4 NORTH

2 WATER WELL OWNER: BEN ARENSMAN JR.
 RR#, St. Address, Box #: RIVER ROAD Board of Agriculture, Division of Water Resources
 City, State, ZIP code: KINSLEY, KS 67547- Application Number:

3 LOCATE WELL'S LOCATION WITH AN "X" IN SECTION BOX:

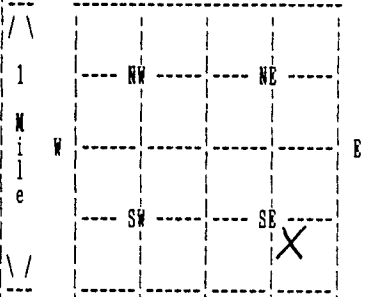

4 DEPTH OF COMPLETED WELL 83 ELEVATION: 0
 Depth(s) Groundwater Encountered 1. 0 ft. 2. 0 ft. 3. 0 ft.

WELL'S STATIC WATER LEVEL 30 ft. below land surface measured on no/day/yr 07/26/95
 Pump test data: Well water was 0 ft. after 0 hours pumping 0 gpm

Estimated Yield 40 gpm: Well water was 0 ft. after 0 hours pumping 0 gpm

Bore Hole Diameter 9 in. to 83 ft., and in. to 0 ft.

WELL WATER TO BE USED AS: DOMESTIC

Was a chemical/bacteriological sample submitted to department? No ;
 If yes, no/day/yr sample was submitted Water well disinfected? Yes

5 TYPE OF BLANK CASING USED: PVC CASING JOINTS: GLUED
 Blank casing diameter 5 in. to 83 ft., Dia in. to 0 ft., Dia in. to 0 ft.
 Casing height above land surface 12 in., weight 200 lbs/ft. Wall thickness or gauge No. 21
 TYPE OF SCREEN OR PERFORATION MATERIAL: PVC
 SCREEN OR PERFORATION OPENINGS ARE: SAW CUT

SCREEN PERFORATED INTERVALS: From 60 ft. to 80 ft., From 0 ft. to 0 ft.
 From 0 ft. to 0 ft., From 0 ft. to 0 ft.
 GRAVEL PACK INTERVALS: From 20 ft. to 83 ft., From 0 ft. to 0 ft.
 From 0 ft. to 0 ft., From 0 ft. to 0 ft.

6 GROUT MATERIAL BENTONITE
 Grout Intervals: From 0 ft. to 20 ft., From 0 ft. to 0 ft., From 0 ft. to 0 ft.
 What is the nearest source of possible contamination: NONE - NEW SITE
 Direction from well? How many feet? 0

FROM	TO	LITHOLOGIC LOG	FROM	TO	PLUGGING INTERVALS
0	20	TOPSOIL FINE SAND			
20	40	MED-COARSE SAND			
40	80	MED-COARSE SAND LARGE GRAVEL			
80	100	CLAY			

7 CONTRACTOR'S OR LANDOWNER'S CERTIFICATION: This water well was constructed under my jurisdiction and was completed on (no/day/year) 07/26/95 and this record is true to the best of my knowledge and belief. Kansas Water Well Contractor's License No. 179 This Water Well Record was completed on (no/day/yr) 08/01/95 under the business name of JOE'S WELL SERVICE, INC. by (signature) *Judith Crist*