


2411064 MW-1

1 LOCATION OF WATER WELL: Fraction NE 1/4 SE 1/4 SW 1/4 Section Number 13 Township Number T 25 S Range Number R 19 E/W
 County: Edwards

Distance and direction from nearest town or city street address of well if located within city?
3 miles South & 2 miles East of Kinsley

2 WATER WELL OWNER: Koch Agriculture, Inc. Board of Agriculture, Division of Water Resources
 RR#, St. Address, Box #: 4111 E 37th St. N.
 City, State, ZIP Code: Wichita KS 67226 Application Number:

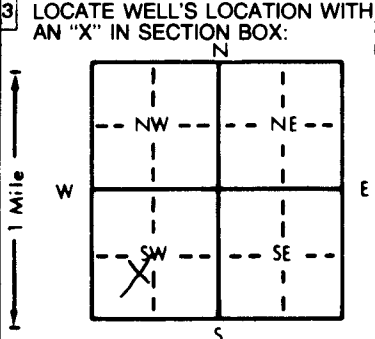

4 DEPTH OF COMPLETED WELL: 52 ft. ELEVATION: _____
 Depth(s) Groundwater Encountered 1. 45 ft. 2. _____ ft. 3. _____ ft.
 WELL'S STATIC WATER LEVEL: 43.25 ft. below land surface measured on mo/day/yr 9/16/96
 Pump test data: Well water was _____ ft. after _____ hours pumping _____ gpm
 Est. Yield _____ gpm: Well water was _____ ft. after _____ hours pumping _____ gpm
 Bore Hole Diameter: 8 in. to _____ ft., and _____ in. to _____ ft.
 WELL WATER TO BE USED AS:
 5 Public water supply 8 Air conditioning 11 Injection well
 1 Domestic 3 Feedlot 6 Oil field water supply 9 Dewatering 12 Other (Specify below)
 2 Irrigation 4 Industrial 7 Lawn and garden only 10 Monitoring well
 Was a chemical/bacteriological sample submitted to Department? Yes _____ No X; If yes, mo/day/yr sample was submitted _____
 Water Well Disinfected? Yes _____ No X

5 TYPE OF BLANK CASING USED:
 1 Steel 3 RMP (SR) 5 Wrought iron 8 Concrete tile CASING JOINTS: Glued _____ Clamped _____
2 PVC 4 ABS 6 Asbestos-Cement 9 Other (specify below) Welded _____
 7 Fiberglass Threaded Flush

Blank casing diameter: 2 in. to _____ ft., Dia _____ in. to _____ ft., Dia _____ in. to _____ ft.
 Casing height above land surface: Flush in., weight 703 lbs./ft. Wall thickness or gauge No. Sch 40

TYPE OF SCREEN OR PERFORATION MATERIAL:
 1 Steel 3 Stainless steel 5 Fiberglass 8 RMP (SR) 10 Asbestos-cement
 2 Brass 4 Galvanized steel 6 Concrete tile 9 ABS 11 Other (specify) _____
 12 None used (open hole)

SCREEN OR PERFORATION OPENINGS ARE:
 1 Continuous slot 3 Mill slot 5 Gauzed wrapped 8 Saw cut 11 None (open hole)
 2 Louvered shutter 4 Key punched 6 Wire wrapped 9 Drilled holes
 7 Torch cut 10 Other (specify) _____

SCREEN-PERFORATED INTERVALS: From 42 ft. to 52 ft., From _____ ft. to _____ ft.
 From _____ ft. to _____ ft., From _____ ft. to _____ ft.
 GRAVEL PACK INTERVALS: From 34 ft. to 52 ft., From _____ ft. to _____ ft.
 From _____ ft. to _____ ft., From _____ ft. to _____ ft.

6 GROUT MATERIAL: 1 Neat cement 2 Cement grout 3 Bentonite 4 Other _____
 Grout Intervals: From 1 ft. to 34 ft., From _____ ft. to _____ ft., From _____ ft. to _____ ft.

What is the nearest source of possible contamination:
 1 Septic tank 4 Lateral lines 7 Pit privy 11 Fuel storage 14 Abandoned water well
 2 Sewer lines 5 Cess pool 8 Sewage lagoon 12 Fertilizer storage 15 Oil well/Gas well
 3 Watertight sewer lines 6 Seepage pit 9 Feedyard 13 Insecticide storage 16 Other (specify below) _____

Direction from well? φ How many feet? In tank basin

FROM	TO	LITHOLOGIC LOG	FROM	TO	PLUGGING INTERVALS
1	12	Sand, silty clay, brown			
12	22	Sand, clayey, brown			
22	29	Sand, sl. clayey, brown			
29	32	Sand, brown v. fine to med grains			
32	36	Sand, brown med to coarse grains			
36	44.5	Sand, brown, fine to v. coarse grains			
44.5	52	Sand, brown, med to v. coarse grains w/ gravel			

Request for the flushmount waiver was sent
 8/30/96. Waiver received 9/6/96

7 CONTRACTOR'S OR LANDOWNER'S CERTIFICATION: This water well was (1) constructed, (2) reconstructed, or (3) plugged under my jurisdiction and was completed on (mo/day/year) 9/14/96 and this record is true to the best of my knowledge and belief. Kansas Water Well Contractor's License No. 531 This Water Well Record was completed on (mo/day/yr) 9/16/96 under the business name of GSI by (signature) Allison J. [Signature]

OFFICE USE ONLY
T
R
EW
SEC.
1/4
1/4
1/4