34

USE TYPEWRITER OR BALL POINT PEN-PRESS FIRMLY, PRINT CLEARLY.

WATER WELL RECORD
KSA 82a-1201-1215

Kansas Department of Health and Environment-Division of Environment
(Water well Contractors)
Topeka, Konsas 66620

1. Location of well:	County: Edwards	Fraction: NW NE NW ~~SW 1/4 SW~~ 1/4	Section number: 4 ~~33~~	Township number: T 25 ~~24~~ S	Range number: R 19 E/W

2. Distance and direction from nearest town or city: City — Kinsley, Ks.
Street address of well location if in city:

3. Owner of well: Loren Lippoldt
R.R. or street: RFD #1
City, state, zip code: Kinsley, Ks. 67547

4. Locate with "X" in section below:

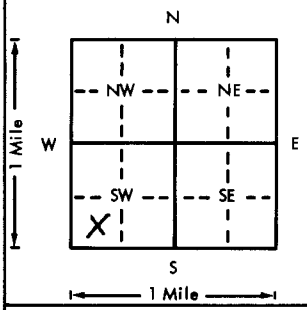

Sketch map:

6. Bore hole dia. 11 in. Completion date _____
Well depth 50 ft. 4-12-77

7. __ Cable tool X Rotary __ Driven __ Dug
__ Hollow rod __ Jetted __ Bored __ Reverse rotary

8. Use: X Domestic __ Public supply __ Industry
__ Irrigation __ Air conditioning __ Stock
__ Lawn __ Oil field water __ Other

9. Casing: Material pvc Height: Above or ~~below~~
Threaded ____ Welded ____ Surface 24 in.
RMP ____ PVC ____ Weight ____ lbs./ft.
Dia. 6½ in. to 50 ft. depth Wall Thickness: inches or
Dia. ____ in. to ____ ft. depth gage No. ~~255~~ 280

10. Screw: Manufacturer's name Certain-Teen
Type pvc Dia. 6½
Slot/~~gauze~~ 1/16 Length 10
Set between 40 ft. and 50 ft.
____ ft. and ____ ft.
Gravel pack? X Size range of material 3/4 ½ 3/8

11. Static water level: mo./day/yr.
10 ft. below land surface Date 4-12-77

12. Pumping level below land surfaces: NA
____ ft. after ____ hrs. pumping ____ g.p.m.
____ ft. after ____ hrs. pumping ____ g.p.m.
Estimated maximum yield ____ g.p.m.

13. Water sample submitted: mo./day/yr.
X Yes ____ No Date 4-12-77

14. Well head completion:
____ Pitless adapter ____ Inches above grade

15. Well grouted? yes
With: X Neat cement ____ Bentonite ____ Concrete
Depth: From 0 ft. to 10 ft.

16. Nearest source of possible contamination:
ft. 60 Direction North Type septic tank
Well disinfected upon completion? X Yes ____ No

17. Pump: X Not installed
Manufacturer's name ____
Model number ____ HP ____ Volts ____
Length of drop pipe ____ ft. capacity ____ g.p.m.
Type:
____ Submersible ____ Turbine
____ Jet ____ Reciprocating
____ Centrifugal ____ Other

5. Type and color of material	From	To
Top Soil	0	3
Gray Brown Clay	3	8
Sand & Gravel	8	24
Brown Clay	24	28
Sand & Garavel	28	50
Cemented Sand	50	53
(Use a second sheet if needed)		

18. Elevation: 2161'
Topography:
____ Hill
____ Slope
X Upland
____ Valley

19. Remarks:

20. Water well contractor's certification:
This well was drilled under my jurisdiction and this report is true to the best of my knowledge and belief.
Business name ~~Rosencrantz-Bemis~~ License No. 134
Address Great Bend, Ks.
Signed Sandy Kilgore Date 8-26-77
Authorized representative

T 25 S R 19 E/W Sec 4 1/4 1/4 1/4 1/4

Forward the white, blue and pink copies to the Department of Health and Environment

Form WWC-5

MI-1023