


1 LOCATION OF WATER WELL: County: EDWARDS Fraction: SE 1/4 SE 1/4 SE 1/4 Section Number: 19 Township Number: T 25 S Range Number: R 19 E/W

Distance and direction from nearest town or city street/address of well if located within city?  
45 W. Kinsley, Kansas

2 WATER WELL OWNER: Jose Archibala Board of Agriculture, Division of Water Resources  
 RR#, St. Address, Box #: Kinsley Kansas Application Number:

3 LOCATE WELL'S LOCATION WITH AN "X" IN SECTION BOX:

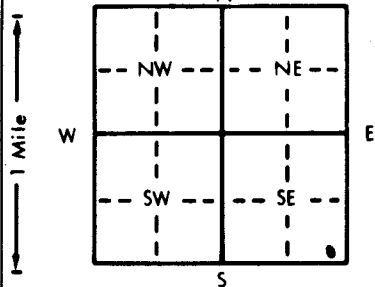

4 DEPTH OF COMPLETED WELL: 80 ft. ELEVATION:  
 Depth(s) Groundwater Encountered: 34 ft. 2. 34 ft. 3. 34 ft.  
 WELL'S STATIC WATER LEVEL: 34 ft. below land surface measured on mo/day/yr 7-25-80  
 Pump test data: Well water was 34 ft. after 1 hours pumping 10 gpm  
 Est. Yield 25 gpm; Well water was 80 ft. after 10 hours pumping 10 gpm  
 Bore Hole Diameter 8 3/4 in. to 80 ft., and 80 in. to 80 ft.  
 WELL WATER TO BE USED AS:  
 1 Domestic     2 Irrigation     3 Feedlot     4 Industrial  
 5 Public water supply     6 Oil field water supply     7 Lawn and garden only  
 8 Air conditioning     9 Dewatering     10 Observation well  
 11 Injection well     12 Other (Specify below)  
 Was a chemical/bacteriological sample submitted to Department? Yes X No X; If yes, mo/day/yr sample was submitted  
 Water Well Disinfected? Yes X No X

5 TYPE OF BLANK CASING USED:  
 1 Steel     3 AMP (SR)    5 Wrought iron    8 Concrete tile    CASING JOINTS: Glued X Clamped X  
 2 PVC     4 ABS    6 Asbestos-Cement    9 Other (specify below)    Welded X  
 7 Fiberglass    Threaded X

Blank casing diameter 50 in. to 50 ft., Dia 5 in. to 70-80 ft., Dia 50 in. to 50 ft.  
 Casing height above land surface 12 in., weight 1.75 lbs./ft. Wall thickness or gauge No SDR-26

TYPE OF SCREEN OR PERFORATION MATERIAL:  
 1 Steel    3 Stainless steel    5 Fiberglass     8 AMP (SR)    10 Asbestos-cement  
 2 Brass    4 Galvanized steel    6 Concrete tile    9 ABS    11 Other (specify) X  
 12 None used (open hole)

SCREEN OR PERFORATION OPENINGS ARE:  
 1 Continuous slot    3 Mill slot    5 Gauzed wrapped     8 Saw cut    11 None (open hole)  
 2 Louvered shutter    4 Key punched    6 Wire wrapped    9 Drilled holes  
 7 Torch cut    10 Other (specify) X

SCREEN-PERFORATED INTERVALS: From 50 ft. to 70 ft., From 50 ft. to 70 ft., From 50 ft. to 70 ft.  
 GRAVEL PACK INTERVALS: From 35 ft. to 80 ft., From 35 ft. to 80 ft., From 35 ft. to 80 ft.

6 GROUT MATERIAL:  1 Neat cement    2 Cement grout    3 Bentonite    4 Other  

What is the nearest source of possible contamination:  
 1 Septic tank    4 Lateral lines    7 Pit privy    10 Livestock pens    14 Abandoned water well  
 2 Sewer lines    5 Cess pool    8 Sewage lagoon    11 Fuel storage    15 Oil well/Gas well  
 3 Watertight sewer lines    6 Seepage pit     9 Feedyard    12 Fertilizer storage    16 Other (specify below)  
 13 Insecticide storage  
 Direction from well? South How many feet? 50

FROM	TO	LITHOLOGIC LOG	FROM	TO	LITHOLOGIC LOG
0	2	Top Soil			
2	12	Sand			
12	17	Clay			
17	66	Gravel			
66	80	Clay			

7 CONTRACTOR'S OR LANDOWNER'S CERTIFICATION: This water well was (1) constructed, (2) reconstructed, or (3) plugged under my jurisdiction and was completed on (mo/day/year) 7-25-80 and this record is true to the best of my knowledge and belief. Kansas Water Well Contractor's License No. 224 This Water Well Record was completed on (mo/day/yr) 7-26-81 under the business name of Carl Hayes Water Well Serv. by (signature) Carl Hayes

INSTRUCTIONS: Use typewriter or ball point pen, PLEASE PRESS FIRMLY and PRINT clearly. Please fill in blanks, underline or circle the correct answers. Send top three copies to Kansas Department of Health and Environment, Division of Environment, Environmental Geology Section, Topeka, KS 66620. Send one to WATER WELL OWNER and retain one for your records.

OFFICE USE ONLY T 25 R 19 E/W SEC. 19 SE 1/4 SE 1/4 SE 1/4