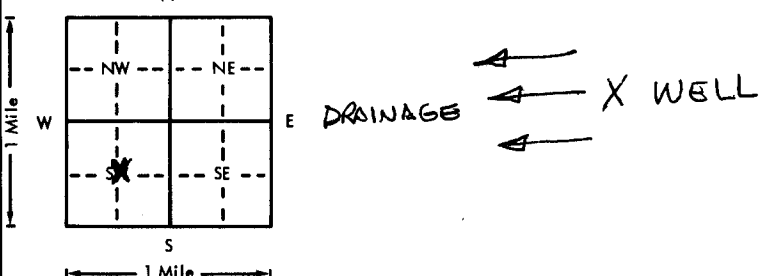


USE TYPEWRITER OR BALL POINT PEN-PRESS FIRMLY, PRINT CLEARLY.

WATER WELL RECORD
KSA 82a-1201-1215

Kansas Department of Health and Environment-Division of Environment
(Water well Contractors)
Topeka, Kansas 66620

| | | | | | | |
|---|--|--|---|-----------------------------|---|--------------|
| 1. Location of well: | | County Edwards | Fraction Sw 1/4 NE 1/4 SW 1/4 | Section number 24 | Township number T 25 S R 19W E/W | Range number |
| 2. Distance and direction from nearest town or city: Street address of well location if in city: | | | 3. Owner of well: R.R. or street: City, state, zip code: | | | |
| 4. Locate with "X" in section below: N W E S 1 Mile 1 Mile | | | Sketch map:  | | 6. Bore hole dia. <u>28</u> in. Completion date <u>23 July 76</u> Well depth <u>95</u> ft. | |
| 5. Type and color of material | | | From | To | 7. <input type="checkbox"/> Cable tool <input type="checkbox"/> Rotary <input type="checkbox"/> Driven <input type="checkbox"/> Dug <input type="checkbox"/> Hollow rod <input type="checkbox"/> Jetted <input type="checkbox"/> Bored <input checked="" type="checkbox"/> Reverse rotary | |
| Sand, fine silty | | | 0 | 4 | 8. Use: <input type="checkbox"/> Domestic <input type="checkbox"/> Public supply <input type="checkbox"/> Industry <input checked="" type="checkbox"/> Irrigation <input type="checkbox"/> Air conditioning <input type="checkbox"/> Stock <input type="checkbox"/> Lawn <input type="checkbox"/> Oil field water <input type="checkbox"/> Other | |
| Sand, fine | | | 4 | 31 | 9. Casing: Material <u>STI</u> Height: <u>Above</u> or below Threaded <input type="checkbox"/> Welded <input checked="" type="checkbox"/> Surface <u>12</u> in. RMP <input type="checkbox"/> PVC <input type="checkbox"/> Weight <input type="checkbox"/> lbs./ft. Dia. <u>16</u> in. to <u>55</u> ft. depth Wall Thickness: inches or Dia. <input type="checkbox"/> in. to <input type="checkbox"/> ft. depth gage No. <u>188</u> | |
| Sand, fine to coarse and medium gravel | | | 31 | 93 | 10. Screen: Manufacturer's name <u>W.A. Brown</u> Type <u>Freeflo</u> Dia. <u>16"</u> <input checked="" type="checkbox"/> Gauze <u>1/8"</u> Length <u>40'</u> Set between <u>55</u> ft. and <u>95</u> ft. <input type="checkbox"/> ft. and <input type="checkbox"/> ft. | |
| Sand, silty-hard | | | 93 | 105 | Gravel pack? <input checked="" type="checkbox"/> yes Size range of material <u>1/2 x 1/8</u> | |
| Clay, tan with silty sand-very hard | | | 105 | 130 | 11. Static water level: <u>33</u> ft. below land surface Date <u>23 July 76</u> mo./day/yr. | |
| | | | | | 12. Pumping level below land surfaces: <u>54</u> ft. after <u>1</u> hrs. pumping <u>1218</u> g.p.m. <u>44</u> ft. after <u>1</u> hrs. pumping <u>791</u> g.p.m. Estimated maximum yield <u>1600</u> g.p.m. | |
| | | | | | 13. Water sample submitted: <input type="checkbox"/> Yes <input checked="" type="checkbox"/> No Date _____ mo./day/yr. | |
| | | | | | 14. Well head completion: <input type="checkbox"/> Pitless adapter _____ inches above grade | |
| | | | | | 15. Well grouted? <u>yes</u> With: <input type="checkbox"/> Neat cement <input checked="" type="checkbox"/> Bentonite <input type="checkbox"/> Concrete Depth: From <u>0</u> ft. to <u>10</u> ft. | |
| | | | | | 16. Nearest source of possible contamination: ft. <u>778</u> Mile <u>NE</u> Direction <u>NE</u> Type <u>Feedlot</u> Well disinfected upon completion? <input checked="" type="checkbox"/> Yes <input type="checkbox"/> No | |
| | | | | | 17. Pump: <input type="checkbox"/> Not installed Manufacturer's name <u>Floway</u> Model number <u>12DOT</u> HP <u>60</u> Volts _____ Length of drop pipe <u>80'</u> ft. capacity <u>800</u> g.p.m. Type: <input type="checkbox"/> Submersible <input checked="" type="checkbox"/> Turbine <input type="checkbox"/> Jet <input type="checkbox"/> Reciprocating <input type="checkbox"/> Centrifugal <input type="checkbox"/> Other | |
| | | | (Use a second sheet if needed) | | | |
| 18. Elevation: | | 19. Remarks: A 5x10x1 Concrete pad was poured at surface. | | | 20. Water well contractor's certification: This well was drilled under my jurisdiction and this report is true to the best of my knowledge and belief. Central Well & Pump 325 Business name License No. _____ Address <u>121 S. Taylor, Pratt</u> Signed <u>John Anemichl</u> Date <u>23 July 76</u> Authorized representative | |
| Topography: <input type="checkbox"/> Hill <input type="checkbox"/> Slope <input checked="" type="checkbox"/> Upland <input type="checkbox"/> Valley | | | | | | |

T 25 S R 19W E/W Sec 24 SW NE SW 1/4 1/4 1/4

Forward the white, blue and pink copies to the Department of Health and Environment

Form WWC-5