USE TYPEWRITER OR BALL POINT PEN-PRESS FIRMLY, PRINT CLEARLY.

T R EW sec 1/4 1/4 1/4 No.

WATER WELL RECORD
KSA 82a-1201-1215

Kansas State Dept. Of Health
(Water Well Contractors)
Forbes-Bldg. 740
Topeka, Kansas 66620

1 Location of well:	County	Township name	Fraction	Section number	Town number	Range number
	Edwards		NW/SW/NW	26	25	19

Distance and direction from nearest town or city: from Kinsley, Ks - 6S each side Rd.
Street address of well location if in city:

3 Owner of well: Jack Miller Rt 1
Address: Kinsley, Ks

Locate with "X" in section below:

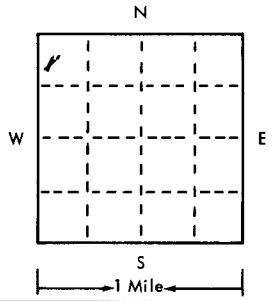

Sketch map:

4 Well depth: 60 ft. Date of completion 3-12-75
Well diameter 7 7/8 in.

5 ☐ Cable tool ☑ Rotary ☐ Driven ☐ Dug
☐ Hollow rod ☐ Jetted ☐ Bored ☐ Reverse rotary

6 Use: ☐ Domestic ☐ Public supply ☐ Industry
☐ Irrigation ☐ Air conditioning ☐ Commercial
☐ Test well ☐ stock well

7 Casing: Material pvc Height: above/below
Threaded ☐ Welded ☒ Surface 12 in.
Diam. Weight 160 lbs./ft.
4 in. to 50 ft. depth Drive shoe? ☐ Yes ☐ No
___ in. to ___ ft. depth

2

Type and color of material	From	To
Sandy top soil	0	2
Sand	2	16
Sand Medium	16	30
Good sand + gravel	30	58
Clay	58	60
(use a second sheet if needed)		

8 Screen:
Manufacturer R+B
Type pvc Dia. 4
Slot gauze 1/16 Length 10
Set between 50 ft. and 60 ft.
Fittings:
Gravel pack ☒ Yes ☐ No Size range of material 1/4-3/8-1/16 CM3

9 Static water level:
26 ft. below land surface Date 3-12-75

10 Pumping level below land surfaces:
30 ft. after 1 hrs. pumping 40 g.p.m.
___ ft. after ___ hrs. pumping ___ g.p.m.
Estimated maximum yield 200 g.p.m.

11 Water sample submitted:
☐ Yes ☑ No Date ___

12 Well head completion:
☐ Pitless adapter ☒ Inches above grade

13 Well grouted? ☑ Yes ☐ No
☐ Neat cement ☑ Bentonite ☐ ___
Depth: From 0 ft. to 10 ft.

14 Nearest source of possible contamination: NA
ft. ___ Direction ___ Type ___
Well disinfected upon completion? ☐ Yes ☒ No

15 Pump: ☒ Not installed
Manufacturer's name ___
Model number ___ HP ___ Volts ___
Length of drop pipe ___ ft. capacity ___ g.m.p.
Type:
☐ Submersible ☐ Turbine
☐ Jet ☐ Reciprocating
☐ Certrifugal ☐ Other

16 Remarks: elevotion
well drilled out in pasture

Topography:
☐ Hill
☑ Slope
☐ Upland
☐ Valley

17 Water well contractor's certificatian:
This well was drilled under my jurisdiction and this report is true to the best of my knowledge and belief.
Rosenorantz - Bemis 134
Business name License No.
Address Great Bend, Kansas
Signed Gridie Dodson Date 3-17-75
Authorized representative

Forward the white, blue and pink copies to the Kansas State Dept. Of Health.

Form WWC-5

677-H