


1 LOCATION OF WATER WELL: County: Edwards Fraction: SE 1/4 NE 1/4 SE 1/4 Section Number: 31 Township Number: T 25 S Range Number: R 19 EW

Distance and direction from nearest town or city street address of well if located within city? 1/2 S 6 SW of Kinsley

2 WATER WELL OWNER: DON Goldman RR#, St. Address, Box #: 2 Shepard Ave E Suite 900 City, State, ZIP Code: Willow Dale Ontario Canada M2N5Y7 Board of Agriculture, Division of Water Resources Application Number: 4A 21731

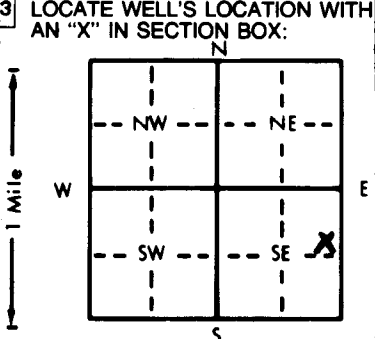

4 DEPTH OF COMPLETED WELL: 66 ft. ELEVATION: _____

Depth(s) Groundwater Encountered 1. 21 ft. 2. 30 ft. 3. _____ ft.

WELL'S STATIC WATER LEVEL 21 ft. below land surface measured on mo/day/yr

Pump test data: Well water was _____ ft. after _____ hours pumping _____ gpm

Est. Yield _____ gpm: Well water was _____ ft. after _____ hours pumping _____ gpm

Bore Hole Diameter: 30 in. to 66 ft., and _____ in. to _____ ft.

WELL WATER TO BE USED AS:

5 Public water supply	8 Air conditioning	11 Injection well
1 Domestic	3 Feedlot	6 Oil field water supply
2 Irrigation	4 Industrial	7 Lawn and garden only
9 Dewatering	10 Observation well	12 Other (Specify below)

Was a chemical/bacteriological sample submitted to Department? Yes _____ No X; If yes, mo/day/yr sample was submitted _____

Water Well Disinfected? Yes _____ No X

5 TYPE OF BLANK CASING USED:

1 Steel	3 RMP (SR)	5 Wrought iron	8 Concrete tile	CASING JOINTS: <u>Glued</u>
2 PVC	4 ABS	6 Asbestos-Cement	9 Other (specify below)	Clamped _____
7 Fiberglass				Welded _____
				Threaded _____

Blank casing diameter 16 in. to 26 ft., Dia _____ in. to _____ ft., Dia _____ in. to _____ ft.

Casing height above land surface 12 in., weight _____ lbs./ft. Wall thickness or gauge No. sch 40

TYPE OF SCREEN OR PERFORATION MATERIAL: PVC

1 Steel	3 Stainless steel	5 Fiberglass	8 RMP (SR)	11 Other (specify) _____
2 Brass	4 Galvanized steel	6 Concrete tile	9 ABS	12 None used (open hole)

SCREEN OR PERFORATION OPENINGS ARE:

1 Continuous slot	3 Mill slot	5 Gauzed wrapped	8 Saw cut	11 None (open hole)
2 Louvered shutter	4 Key punched	6 Wire wrapped	9 Drilled holes	
7 Torch cut	10 Other (specify) _____			

SCREEN-PERFORATED INTERVALS: From 26 ft. to 66 ft., From _____ ft. to _____ ft.

GRAVEL PACK INTERVALS: From 20 ft. to 66 ft., From _____ ft. to _____ ft.

6 GROUT MATERIAL: 1 Neat cement 2 Cement grout 3 Bentonite 4 Other _____

Grout Intervals: From 0 ft. to 20 ft., From _____ ft. to _____ ft., From _____ ft. to _____ ft.

What is the nearest source of possible contamination:

1 Septic tank	4 Lateral lines	7 Pit privy	10 Livestock pens	14 Abandoned water well
2 Sewer lines	5 Cess pool	8 Sewage lagoon	11 Fuel storage	15 Oil well/Gas well
3 Watertight sewer lines	6 Seepage pit	9 Feedyard	12 Fertilizer storage	16 Other (specify below)
			13 Insecticide storage	<u>Fertilizer</u>

Direction from well? N E S How many feet? 25

FROM	TO	LITHOLOGIC LOG	FROM	TO	LITHOLOGIC LOG
<u>0</u>	<u>7</u>	<u>SAND</u>			
<u>7</u>	<u>27</u>	<u>GRAVEL</u>			
<u>27</u>	<u>30</u>	<u>CLAY</u>			
<u>30</u>	<u>43</u>	<u>GRAVEL</u>			
<u>43</u>	<u>70</u>	<u>CLAY (Blue)</u>			

7 CONTRACTOR'S OR LANDOWNER'S CERTIFICATION: This water well was (1) constructed, (2) reconstructed, or (3) plugged under my jurisdiction and was completed on (mo/day/year) 5-15-87 and this record is true to the best of my knowledge and belief. Kansas Water Well Contractor's License No. 390 This Water Well Record was completed on (mo/day/yr) 5-15-87 under the business name of Julia Drilling by (signature) _____

OFFICE USE ONLY
T
R
EW
SEC.
1/4
1/4
1/4