


1 LOCATION OF WATER WELL: County: Edwards Fraction: $\frac{1}{4}$ SW $\frac{1}{4}$ NE $\frac{1}{4}$ Section Number: 31 Township Number: T 25 S Range Number: R 19 E/W

Distance and direction from nearest town or city street address of well if located within city?
±6 miles S.W. of Kinsley, Kansas GM-6S

2 WATER WELL OWNER: Farmers Grain & Supply Co.
 RR#, St. Address, Box #: 311 North Main
 City, State, ZIP Code: Greensburg, Kansas 67454-1599
 Board of Agriculture, Division of Water Resources
 Application Number:

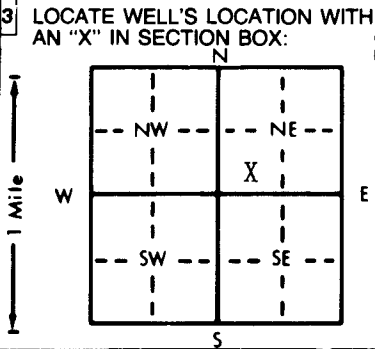

4 DEPTH OF COMPLETED WELL: 31.0 ft. ELEVATION:
 Depth(s) Groundwater Encountered: 1. 16.7 ft. 2. ft. 3. ft.
 WELL'S STATIC WATER LEVEL ft. below land surface measured on mo/day/yr
 Pump test data: Well water was ft. after hours pumping gpm
 Est. Yield gpm: Well water was ft. after hours pumping gpm
 Bore Hole Diameter: 8 in. to 33 in. to in. to in.
 WELL WATER TO BE USED AS: 5 Public water supply 8 Air conditioning 11 Injection well
 1 Domestic 3 Feedlot 6 Oil field water supply 9 Dewatering 12 Other (Specify below)
 2 Irrigation 4 Industrial 7 Lawn and garden only 10 Monitoring well
 Was a chemical/bacteriological sample submitted to Department? Yes.....No.....; If yes, mo/day/yr sample was submitted
 Water Well Disinfected? Yes No

5 TYPE OF BLANK CASING USED: 1 Steel 2 PVC 3 RMP (SR) 4 ABS 5 Wrought iron 6 Asbestos-Cement 7 Fiberglass 8 Concrete tile 9 Other (specify below) CASING JOINTS: Glued Clamped Welded Threaded:
 Blank casing diameter: 2 in. to 31 ft. Dia. in. to ft. Dia. in. to ft.
 Casing height above land surface: 24 in., weight lbs./ft. Wall thickness or gauge No. Sch. 40
 TYPE OF SCREEN OR PERFORATION MATERIAL: 1 Steel 2 Brass 3 Stainless steel 4 Galvanized steel 5 Fiberglass 6 Concrete tile 7 PVC 8 RMP (SR) 9 ABS 10 Asbestos-cement 11 Other (specify) 12 None used (open hole)
 SCREEN OR PERFORATION OPENINGS ARE: 1 Continuous slot 2 Louvered shutter 3 Mill slot 4 Key punched 5 Gauzed wrapped 6 Wire wrapped 7 Torch cut 8 Saw cut 9 Drilled holes 11 None (open hole) 10 Other (specify)
 SCREEN-PERFORATED INTERVALS: From 30.5 ft. to 15.5 ft. From ft. to ft.
 GRAVEL PACK INTERVALS: From 33 ft. to 13.5 ft. From ft. to ft.

6 GROUT MATERIAL: 1 Neat cement 2 Cement grout 3 Bentonite 4 Other Bentonite Pellets 13.5-11.5'
 Grout Intervals: From 11.5 ft. to 3 ft. From ft. to ft.
 What is the nearest source of possible contamination: 1 Septic tank 2 Sewer lines 3 Watertight sewer lines 4 Lateral lines 5 Cess pool 6 Seepage pit 7 Pit privy 8 Sewage lagoon 9 Feedyard 10 Livestock pens 11 Fuel storage 12 Fertilizer storage 13 Insecticide storage 14 Abandoned water well 15 Oil well/Gas well 16 Other (specify below) Pesticide Burn Pit
 Direction from well? E How many feet? ±1200

FROM	TO	LITHOLOGIC LOG	FROM	TO	PLUGGING INTERVALS
0'	6'	Brown Sandy Silt			
6'	12'	Brown Silty Sand			
12'	33'	Brown Coarse Sand w/Gravel			

7 CONTRACTOR'S OR LANDOWNER'S CERTIFICATION: This water well was constructed, (2) reconstructed, or (3) plugged under my jurisdiction and was completed on (mo/day/year) .. 5/20/93 and this record is true to the best of my knowledge and belief. Kansas Water Well Contractor's License No. 510 This Water Well Record was completed on (mo/day/yr) June 3, 1993 under the business name of MIKON Corporation by (signature) David D. Kramer

OFFICE USE ONLY T R E/W SEC. 1/4 1/4 1/4