


WATER WELL RECORD Form WWC-5 KSA 82a-1212

1 LOCATION OF WATER WELL: ; Fraction ; Section Number ; Township Number ; Range Number
 COUNTY: 024 EDWARDS ; NE 1/4 NE 1/4 SE 1/4 ; 36 ; T 25 S ; R 19 W

Distance and direction from nearest town or city street address of well if located within city?
 3 E, 5 1/2 S, OF KINSLEY, KS

2 WATER WELL OWNER: MRS. ELMER HUFF EST. 146
 RR#, St. Address, Box #: Board of Agriculture, Division of Water Resources
 City, State, ZIP code : LEWIS, KS - Application Number:

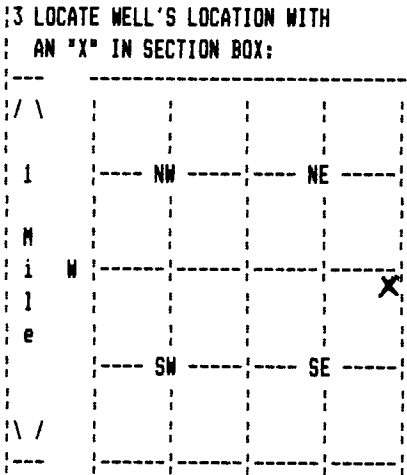

4 DEPTH OF COMPLETED WELL 100 ELEVATION:
 Depth(s) Groundwater Encountered 1. 44 ft. 2. ft. 3. ft.
 WELL'S STATIC WATER LEVEL 44 ft. below land surface measured on mo/day/yr
 Pump test data: Well water was ft. after hours pumping gpm
 Estimated Yield gpm: Well water was ft. after hours pumping gpm
 Bore Hole Diameter 8.75 in. to 100 ft., and in. to ft.
 WELL WATER TO BE USED AS: 01 DOMESTIC
 Was a chemical/bacteriological sample submitted to department? No ;
 If yes, mo/day/yr sample was submitted Water well disinfected? Yes

5 TYPE OF BLANK CASING USED: 02 PVC CASING JOINTS: BLUED
 Blank casing diameter 5 in. to 80 ft., Dia in. to ft., Dia in. to ft.
 Casing height above land surface 12 in., weight lbs/ft. Wall thickness or gauge No. 26
 TYPE OF SCREEN OR PERFORATION MATERIAL: 07 PVC
 SCREEN OR PERFORATION OPENINGS ARE: 08 SAW CUT

SCREEN PERFORATED INTERVALS: From 80 ft. to 100 ft., From ft. to ft.
 From ft. to ft., From ft. to ft.
 GRAVEL PACK INTERVALS: From 25 ft. to 100 ft., From ft. to ft.
 From ft. to ft., From ft. to ft.

6 GROUT MATERIAL 03 BENTONITE
 Grout Intervals: From 1 ft. to 25 ft., From ft. to ft., From ft. to ft.
 What is the nearest source of possible contamination: CATTLE PASTURE
 Direction from well? ALL How many feet? 3

FROM	TO	LITHOLOGIC LOG	FROM	TO	PLUGGING INTERVALS
	18	SILT & SAND			
18	26	TAN CLAY			
26	100	05 SAND AND 17 GRAVEL			

7 CONTRACTOR'S OR LANDOWNER'S CERTIFICATION: This water well was Constructed under my jurisdiction and was completed on (mo/day/year) 5 / 7 / 92 and this record is true to the best of my knowledge and belief. Kansas Water Well Contractor's License No. 224 This Water Well Record was completed on (mo/day/yr) 06/15/92 under the business name of CARL HAYSE WATER WELL SVC by (signature) Carl Hayse