


1 LOCATION OF WATER WELL: County: Edwards Fraction: NW 1/4 NW 1/4 NE 1/4 Section Number: 22 Township Number: T 25 S Range Number: R 19 E/W

Distance and direction from nearest town or city street address of well if located within city?  
3 miles south of Kingsley

2 WATER WELL OWNER: Jim Richard  
 RR#, St. Address, Box #: 201 Est 1st  
 City, State, ZIP Code: Medicine Lodge Kansas 67104  
 Board of Agriculture, Division of Water Resources  
 Application Number:

3 LOCATE WELL'S LOCATION WITH AN "X" IN SECTION BOX:

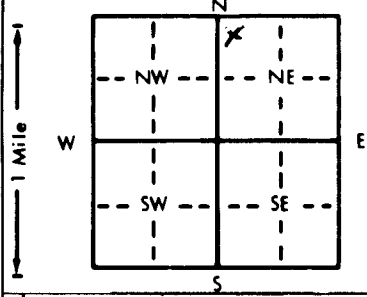

4 DEPTH OF COMPLETED WELL: 68 ft. ELEVATION:

Depth(s) Groundwater Encountered 1. 16 ft. 2. 16 ft. 3. 16 ft.  
 WELL'S STATIC WATER LEVEL 16 ft. below land surface measured on mo/day/yr 7-29-2000  
 Pump test data: Well water was \_\_\_\_\_ ft. after \_\_\_\_\_ hours pumping \_\_\_\_\_ gpm  
 Est. Yield \_\_\_\_\_ gpm: Well water was \_\_\_\_\_ ft. after \_\_\_\_\_ hours pumping \_\_\_\_\_ gpm  
 Bore Hole Diameter: 8.34 in. to \_\_\_\_\_ ft., and \_\_\_\_\_ in. to \_\_\_\_\_ ft.  
 WELL WATER TO BE USED AS:  
 1 Domestic 1 3 Feedlot 3 6 Oil field water supply 6 9 Dewatering 9 12 Other (Specify below)  
 2 Irrigation 2 4 Industrial 4 7 Lawn and garden only 7 10 Monitoring well 10  
 Was a chemical/bacteriological sample submitted to Department? Yes \_\_\_\_\_ No X; If yes, mo/day/yr sample was submitted \_\_\_\_\_  
 Water Well Disinfected? Yes X No \_\_\_\_\_

5 TYPE OF BLANK CASING USED:  
 1 Steel \_\_\_\_\_ 3 RMP (SR) \_\_\_\_\_ 5 Wrought iron \_\_\_\_\_ 8 Concrete tile \_\_\_\_\_ CASING JOINTS: Glued X Clamped \_\_\_\_\_  
 2 PVC 2 4 ABS \_\_\_\_\_ 6 Asbestos-Cement \_\_\_\_\_ 9 Other (specify below) \_\_\_\_\_ Welded \_\_\_\_\_  
 7 Fiberglass \_\_\_\_\_ Threaded \_\_\_\_\_

Blank casing diameter 5 in. to 58 ft., Dia \_\_\_\_\_ in. to \_\_\_\_\_ ft., Dia \_\_\_\_\_ in. to \_\_\_\_\_ ft.  
 Casing height above land surface 12 in., weight \_\_\_\_\_ lbs./ft. Wall thickness or gauge No. 5DR24

TYPE OF SCREEN OR PERFORATION MATERIAL:  
 1 Steel \_\_\_\_\_ 3 Stainless steel \_\_\_\_\_ 5 Fiberglass \_\_\_\_\_ 7 PVC 7 10 Asbestos-cement \_\_\_\_\_  
 2 Brass \_\_\_\_\_ 4 Galvanized steel \_\_\_\_\_ 6 Concrete tile \_\_\_\_\_ 8 RMP (SR) \_\_\_\_\_ 11 Other (specify) \_\_\_\_\_  
 9 ABS \_\_\_\_\_ 12 None used (open hole) \_\_\_\_\_

SCREEN OR PERFORATION OPENINGS ARE:  
 1 Continuous slot \_\_\_\_\_ 3 Mill slot \_\_\_\_\_ 5 Gauzed wrapped \_\_\_\_\_ 8 Saw cut 8 11 None (open hole) \_\_\_\_\_  
 2 Louvered shutter \_\_\_\_\_ 4 Key punched \_\_\_\_\_ 6 Wire wrapped \_\_\_\_\_ 9 Drilled holes \_\_\_\_\_  
 7 Torch cut \_\_\_\_\_ 10 Other (specify) \_\_\_\_\_

SCREEN-PERFORATED INTERVALS: From 58 ft. to 68 ft., From \_\_\_\_\_ ft. to \_\_\_\_\_ ft., From \_\_\_\_\_ ft. to \_\_\_\_\_ ft.  
 From \_\_\_\_\_ ft. to \_\_\_\_\_ ft., From \_\_\_\_\_ ft. to \_\_\_\_\_ ft., From \_\_\_\_\_ ft. to \_\_\_\_\_ ft.  
 GRAVEL PACK INTERVALS: From 25 ft. to 68 ft., From \_\_\_\_\_ ft. to \_\_\_\_\_ ft., From \_\_\_\_\_ ft. to \_\_\_\_\_ ft.  
 From \_\_\_\_\_ ft. to \_\_\_\_\_ ft., From \_\_\_\_\_ ft. to \_\_\_\_\_ ft., From \_\_\_\_\_ ft. to \_\_\_\_\_ ft.

6 GROUT MATERIAL: 1 Neat cement \_\_\_\_\_ 2 Cement grout 2 3 Bentonite \_\_\_\_\_ 4 Other \_\_\_\_\_  
 Grout Intervals: From 5 ft. to 25 ft., From \_\_\_\_\_ ft. to \_\_\_\_\_ ft., From \_\_\_\_\_ ft. to \_\_\_\_\_ ft., From \_\_\_\_\_ ft. to \_\_\_\_\_ ft.

What is the nearest source of possible contamination:  
 1 Septic tank 1 4 Lateral lines \_\_\_\_\_ 7 Pit privy \_\_\_\_\_ 10 Livestock pens \_\_\_\_\_ 14 Abandoned water well \_\_\_\_\_  
 2 Sewer lines \_\_\_\_\_ 5 Cess pool \_\_\_\_\_ 8 Sewage lagoon \_\_\_\_\_ 11 Fuel storage \_\_\_\_\_ 15 Oil well/Gas well \_\_\_\_\_  
 3 Watertight sewer lines 3 6 Seepage pit \_\_\_\_\_ 9 Feedyard \_\_\_\_\_ 12 Fertilizer storage \_\_\_\_\_ 16 Other (specify below) \_\_\_\_\_  
 13 Insecticide storage \_\_\_\_\_

Direction from well? North How many feet? 200'

FROM	TO	LITHOLOGIC LOG	FROM	TO	PLUGGING INTERVALS
0	4	Silt + Sand			
4	10	Tan Clay			
10	60	Sand + Gravel			
50	55	Tan Clay			
55	68	Sand + Gravel			
68		Tan Clay			

7 CONTRACTOR'S OR LANDOWNER'S CERTIFICATION: This water well was (1) constructed, (2) reconstructed, or (3) plugged under my jurisdiction and was completed on (mo/day/year) 7-29-2000 and this record is true to the best of my knowledge and belief. Kansas Water Well Contractor's License No. 653 This Water Well Record was completed on (mo/day/yr) 8-27-2000 under the business name of Don Hays Water Well Service by (signature) Don Hays

OFFICE USE ONLY T R E/W SEC. 1/4 1/4 1/4 1/4