


1 LOCATION OF WATER WELL: Fraction Section Number Township Number Range Number  
 COUNTY: EDWARDS SE 1/4 NW 1/4 NW 1/4 11 T 25 S R 19 W

Distance and direction from nearest town or city street address of well if located within city?  
 1 MILE EAST, 2 MILES SOUTH OF KINSLEY

2 WATER WELL OWNER: CONVERSE, STEVE  
 RR#, St. Address, Box #: 1413 OAK SPRINGS LANE Board of Agriculture, Division of Water Resources  
 City, State, ZIP code : EDMOND, OK 73034- Application Number:

3 LOCATE WELL'S LOCATION WITH AN "X" IN SECTION BOX:

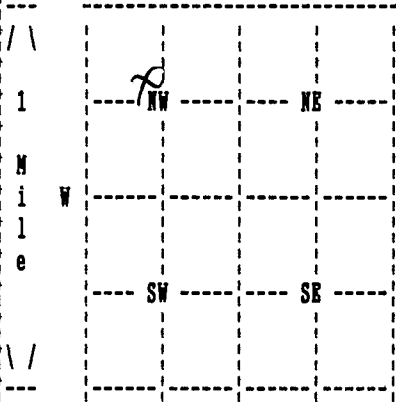

4 DEPTH OF COMPLETED WELL 13 ELEVATION: 0  
 Depth(s) Groundwater Encountered 1. 0 ft. 2. 0 ft. 3. 0 ft.

WELL'S STATIC WATER LEVEL 13 ft. below land surface measured on mo/day/yr 07/20/03  
 Pump test data: Well water was 0 ft. after 0 hours pumping 0 gpm

Estimated Yield 0 gpm: Well water was 0 ft. after 0 hours pumping 0 gpm

Bore Hole Diameter in. to 0 ft., and in. to 0 ft.

WELL WATER WAS: LIVESTOCK

Was a chemical/bacteriological sample submitted to department? No ;  
 If yes, mo/day/yr sample was submitted Water well disinfected? Yes

5 TYPE OF BLANK CASING USED: STEEL CASING JOINTS: OTHER CASING JNT  
 Blank casing diameter 5 in. to 0 ft., Dia in. to 0 ft., Dia in. to 0 ft.  
 Casing height above land surface -48 in., weight 0 lbs/ft. Wall thickness or gauge No.  
 TYPE OF SCREEN OR PERFORATION MATERIAL: GALVANIZED STEEL  
 SCREEN OR PERFORATION OPENINGS ARE: KEY PUNCHED

SCREEN PERFORATED INTERVALS: From 0 ft. to 0 ft., From 0 ft. to 0 ft.  
 GRAVEL PACK INTERVALS: From 0 ft. to 0 ft., From 0 ft. to 0 ft.  
 From 0 ft. to 0 ft., From 0 ft. to 0 ft.

6 GROUT MATERIAL  
 Grout Intervals: From 0 ft. to 0 ft., From 0 ft. to 0 ft., From 0 ft. to 0 ft.  
 What is the nearest source of possible contamination: LIVESTOCK PENS  
 Direction from well? WEST How many feet? 6000

FROM	TO	LITHOLOGIC LOG	FROM	TO	PLUGGING INTERVALS
			13	4	BENTONITE
			0	0	
			0	0	
			0	0	
			0	0	
			0	0	
			0	0	
			0	0	
			0	0	
			0	0	

7 CONTRACTOR'S OR LANDOWNER'S CERTIFICATION: This water well was Plugged under my jurisdiction and was completed on (mo/day/year) 07/20/03 and this record is true to the best of my knowledge and belief. Kansas  
 Water Well Contractor's License No. 653A This Water Well Record was completed on (mo/day/yr) 10/09/03  
 under the business name of DAN HAYSE WATER WELL SVC. by (signature) Dan Hayse