


1 LOCATION OF WATER WELL: Fraction Section Number Township Number Range Number
 COUNTY: EDWARDS NW 1/4 NE 1/4 NE 1/4 22 T 25 S R 19 W

Distance and direction from nearest town or city street address of well if located within city?
 3 MILES SOUTH OF KINSLEY

2 WATER WELL OWNER: HUNTLEY, BILL
 RR#, St. Address, Box #: RR 1 BOX 118 Board of Agriculture, Division of Water Resources
 City, State, ZIP code: KINSLEY, KS 67547- Application Number:

3 LOCATE WELL'S LOCATION WITH AN "X" IN SECTION BOX: 4 DEPTH OF COMPLETED WELL 76 ELEVATION: 0
 Depth(s) Groundwater Encountered 1. 0 ft. 2. 0 ft. 3. 0 ft.

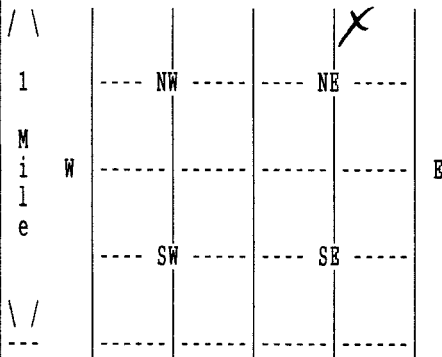

WELL'S STATIC WATER LEVEL 21 ft. below land surface measured on mo/day/yr 05/02/05
 Pump test data: Well water was 0 ft. after 0 hours pumping 0 gpm
 Estimated Yield 0 gpm: Well water was 0 ft. after 0 hours pumping 0 gpm
 Bore Hole Diameter 8.75 in. to 76 ft., and in. to 0 ft.
 WELL WATER TO BE USED AS: LIVESTOCK
 Was a chemical/bacteriological sample submitted to department? No ;
 If yes, mo/day/yr sample was submitted Water well disinfected? Yes

5 TYPE OF BLANK CASING USED: PVC CASING JOINTS: GLUED
 Blank casing diameter 5 in. to 66 ft., Dia in. to 0 ft., Dia in. to 0 ft.
 Casing height above land surface 24 in., weight 0 lbs/ft. Wall thickness or gauge No. 26
 TYPE OF SCREEN OR PERFORATION MATERIAL: PVC
 SCREEN OR PERFORATION OPENINGS ARE: SAW CUT

SCREEN PERFORATED INTERVALS: From 66 ft. to 76 ft., From 0 ft. to 0 ft.
 From 0 ft. to 0 ft., From 0 ft. to 0 ft.
 GRAVEL PACK INTERVALS: From 22 ft. to 76 ft., From 0 ft. to 0 ft.
 From 0 ft. to 0 ft., From 0 ft. to 0 ft.

6 GROUT MATERIAL BENTONITE
 Grout Intervals: From 0 ft. to 22 ft., From 0 ft. to 0 ft., From 0 ft. to 0 ft.
 What is the nearest source of possible contamination: SEPTIC TANK
 Direction from well? EAST How many feet? 2000

FROM	TO	LITHOLOGIC LOG	FROM	TO	PLUGGING INTERVALS
0	14	SILT AND SAND			
14	31	SAND AND GRAVEL			
31	36	TAN CLAY			
36	55	SAND AND GRAVEL			
55	62	TAN CLAY			
62	75	SAND AND GRAVEL			
75	76	TAN CLAY			

7 CONTRACTOR'S OR LANDOWNER'S CERTIFICATION: This water well was Constructed under my jurisdiction and was completed on (mo/day/year) 05/02/05 and this record is true to the best of my knowledge and belief. Kansas
 Water Well Contractor's License No. 653 This Water Well Record was completed on (mo/day/yr) 06/22/05
 under the business name of DAN HAYSE WATER WELL SERV by (signature) Dan Hayse