


1 LOCATION OF WATER WELL: Fraction Section Number Township Number Range Number  
 COUNTY: EDWARDS SE 1/4 SE 1/4 SE 1/4 19 T 25 S R 19 *SW*

Distance and direction from nearest town or city street address of well if located within city?  
 FROM KINSLEY ON 182 - 2 MILES ~~EAST~~ <sup>South</sup> AND 3 1/4 MILES WEST

2 WATER WELL OWNER: KINDEVATER, DENNIS  
 RR#, St. Address, Box #: ROUTE #1 -- BOX 82E Board of Agriculture, Division of Water Resources  
 City, State, ZIP code: KINSLEY, KS 67547- Application Number:

3 LOCATE WELL'S LOCATION WITH AN "X" IN SECTION BOX: 4 DEPTH OF COMPLETED WELL 80 ELEVATION: 0  
 Depth(s) Groundwater Encountered 1. 0 ft. 2. 0 ft. 3. 0 ft.

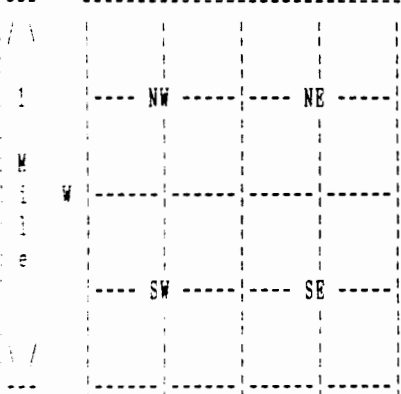

WELL'S STATIC WATER LEVEL 11 ft. below land surface measured on mo/day/yr 11/29/04  
 Pump test data: Well water was 0 ft. after 0 hours pumping 0 gpm  
 Estimated Yield 180 gpm: Well water was 0 ft. after 0 hours pumping 0 gpm  
 Bore Hole Diameter 14 in. to 80 ft., and in. to 0 ft.  
 WELL WATER TO BE USED AS: DOMESTIC  
 Was a chemical/bacteriological sample submitted to department? No ;  
 If yes, mo/day/yr sample was submitted Water well disinfected? Yes

5 TYPE OF BLANK CASING USED: PVC CASING JOINTS: GLUED  
 Blank casing diameter 10 in. to 80 ft., Dia in. to 0 ft., Dia in. to 0 ft.  
 Casing height above land surface 12 in., weight 200 lbs/ft. Wall thickness or gauge No. 40 *sch - PVC*  
 TYPE OF SCREEN OR PERFORATION MATERIAL: PVC  
 SCREEN OR PERFORATION OPENINGS ARE: SAW CUT

SCREEN PERFORATED INTERVALS: From 20 ft. to 60 ft., From 0 ft. to 0 ft.  
 From 0 ft. to 0 ft., From 0 ft. to 0 ft.  
 GRAVEL PACK INTERVALS: From 20 ft. to 80 ft., From 0 ft. to 0 ft.  
 From 0 ft. to 0 ft., From 0 ft. to 0 ft.

6 GROUT MATERIAL BENTONITE  
 Grout Intervals: From 5 ft. to 20 ft., From 0 ft. to 0 ft., From 0 ft. to 0 ft.  
 What is the nearest source of possible contamination: NONE  
 Direction from well? How many feet? 0

FROM	TO	LITHOLOGIC LOG	FROM	TO	PLUGGING INTERVALS
0	20	01 TOPSOIL 02 FINE SAND 05 CLAY			
20	58	05 CLAY 37 FIN-COAR SAN 09 GRAVEL ( <i>Smell - mud</i> )			
58	80	16 GRAY CLAY 26 RED CLAY			

7 CONTRACTOR'S OR LANDOWNER'S CERTIFICATION: This water well was Constructed under my jurisdiction and was completed on (mo/day/year) 12/03/04 and this record is true to the best of my knowledge and belief. Kansas Water Well Contractor's License No. 179 This Water Well Record was completed on (mo/day/yr) 12/16/04 under the business name of JOB'S WELL SERVICE, INC. by (signature) *Justin Critt*