

WATER WELL RECORD

Form WWC-5


Division of Water Resources App. No.

20110123

1 LOCATION OF WATER WELL: County: Edwards Fraction 1/4 NW 1/4 SW 1/4 SE 1/4 Section Number 34 Township No. T 25 S Range Number R 19 [] E [x] W

Street/Rural Address of Well Location; if unknown, distance & direction from nearest town or intersection: If at owner's address, check here []. 5S of Kinsley, KS Global Positioning System (GPS) information: Latitude: Longitude: Elevation: Datum: [] WGS 84, [] NAD 83, [] NAD 27 Collection Method: [] GPS unit, [] Digital Map/Photo, [] Topographic Map, [] Land Survey Est. Accuracy: [] <3 m, [] 3-5 m, [] 5-15 m, [] >15 m

2 WATER WELL OWNER: Clorene J Smith RR#, Street Address, Box #: 3001 Ivv Drive. Apt # 406 City, State, ZIP Code : North Newton. KS 67117

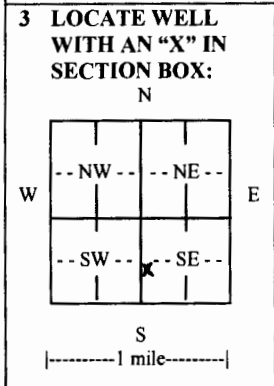

3 LOCATE WELL WITH AN 'X' IN SECTION BOX: 4 DEPTH OF COMPLETED WELL 133 ft. Depth(s) Groundwater Encountered (1) 70 ft. (2) ft. (3) ft. WELL'S STATIC WATER LEVEL 70 ft. below land surface measured on mo/day/yr. 03/31/11 Pump test data: Well water was ft. after hours pumping gpm EST. YIELD 80 gpm. Well water was ft. after hours pumping gpm Bore Hole Diameter in. to ft., and in. to ft. WELL WATER TO BE USED AS: [] Public water supply [] Geothermal [] Injection well [] Domestic [] Feedlot [x] Oil field water supply [] Dewatering [] Other (Specify below) [] Irrigation [] Industrial [] Domestic-lawn & garden [] Monitoring well Was a chemical/bacteriological sample submitted to Department? [] Yes [x] No If yes, mo/day/yr sample was submitted Water well disinfected? [x] Yes [] No

5 TYPE OF CASING USED: [] Steel [x] PVC [] Other CASING JOINTS: [x] Glued [] Clamped [] Welded [] Threaded Casing diameter .5 in. to .73 ft., Diameter in. to ft., Diameter in. to ft. Casing height above land surface .12 in., Weight 2.8 lbs./ft., Wall thickness or gauge No. Sch. 40 TYPE OF SCREEN OR PERFORATION MATERIAL: [] Steel [] Stainless Steel [x] PVC [] Other (Specify) [] Brass [] Galvanized Steel [] None used (open hole) SCREEN OR PERFORATION OPENINGS ARE: [] Continuous slot [] Mill slot [] Gauze wrapped [] Torch cut [] Drilled holes [] None (open hole) [] Louvered shutter [] Key punched [] Wire wrapped [x] Saw cut [] Other (specify) SCREEN-PERFORATED INTERVALS: From .73 ft. to 133 ft., From ft. to ft., From ft. to ft. GRAVEL PACK INTERVALS: From .20 ft. to 133 ft., From ft. to ft., From ft. to ft.

6 GROUT MATERIAL: [] Neat cement [] Cement grout [x] Bentonite [] Other Grout Intervals: From 0 ft. to 20 ft., From ft. to ft., From ft. to ft. What is the nearest source of possible contamination: [] Septic tank [] Lateral lines [] Pit privy [] Livestock pens [] Insecticide storage [] Other (specify below) [] Sewer lines [] Cesspool [] Sewage lagoon [] Fuel storage [] Abandoned water well [] Watertight sewer lines [] Seepage pit [] Feedyard [] Fertilizer storage [x] Oil well/gas well Direction from well South Distance from well .150

FROM	TO	LITHOLOGIC LOG	FROM	TO	LITHO. LOG (cont.) or PLUGGING INTERVALS
0	17	top sand			
17	52	clay			Smith C 1-34
52	133	sand and gravel with clay streaks			
		clay bottom			Sterling Drilling Company
					P O Box 1006
					Pratt. KS 67124

7 CONTRACTOR'S OR LANDOWNER'S CERTIFICATION: This water well was [x] constructed, [] reconstructed, or [] plugged under my jurisdiction and was completed on (mo/day/year) 03/31/11 and this record is true to the best of my knowledge and belief. Kansas Water Well Contractor's License No. 186 This Water Well Record was completed on (mo/day/year) 04/04/11 under the business name of Kelly's Water Well Service, Inc. by (signature) K. Adams

INSTRUCTIONS: Use typewriter or ball point pen. PLEASE PRESS FIRMLY and PRINT clearly. Please fill in blanks and check the correct answers. Send three copies (white, blue, pink) to Kansas Department of Health and Environment, Bureau of Water, Geology Section, 1000 SW Jackson St., Suite 420, Topeka, Kansas 66612-1367. Telephone 785-296-5522. Send one copy to WATER WELL OWNER and retain one for your records. Include fee of \$5.00 for each constructed well. Visit us at http://www.kdheks.gov/waterwell/index.html.

STERLING DRILLING COMPANY

P.O. Box 1006
Pratt, Kansas 67124-1006
Phone (620) 672-9508
Federal ID #: 48-1185919

COPY

WATER WELL ACCEPTANCE AGREEMENT

Water Well Name: Smith Trust "C" Unit #1-34

Water Well Location: Section 34 Township 25s 19 19w
County Edwards

Water Well Location (footage): 1020' FSL & 2430 FEL Section 34

Board of Agriculture, Division of Water Resources Application Number: 20110123



This agreement between Sterling Drilling Company, P.O. Box 1006, Pratt, Kansas, 67124, and

Clorene Smith c/o Jack Miller

certifies that they accept the above listed water well that was drilled by Kelly's Water Well Service, Great Bend, Kansas, located approximately 1020' FSL & 2430 FEL of Section 34 Township 25s Range 19w Edwards County Kansas for domestic use only and when the well is no longer needed agrees to plug the well in accordance with the State Regulation KAR 28-30-7.

By signing this agreement, landowner releases Sterling Drilling Company from any further responsibilities relating to the water well described above. Landowner also agrees to allow Sterling Drilling use of this water well for any future drilling operations within section 34 occurring within the next 2 years from this date. A fee of \$250.00 would be paid to the landowner each time Sterling used this water well for said purpose. Sterling Drilling would be responsible for payment of any fees for state and/or county permits required at that time.

June 30, 2011
Date

Gary M Talbott
Gary M Talbott
Operations Manager
Sterling Drilling Company

7-5-11
Date

Clorene Smith c/o Jack Miller
Clorene Smith c/o Jack Miller
Landowner

Copy of the WWC-5 and permits attached

RECEIVED
JUL 12 2011
BUREAU OF WATER