

WATER WELL RECORD

Form WWC-5

Division of Water Resources App. No.


12,787

1 LOCATION OF WATER WELL: County: <u>Edwards</u>	Fraction <u>1/4 NE 1/4 SE 1/4 NW 1/4</u>	Section Number <u>5</u>	Township No. <u>T 25 S</u>	Range Number <u>R 19</u> <input type="checkbox"/> E <input checked="" type="checkbox"/> W
--	---	----------------------------	-------------------------------	--

Street/Rural Address of Well Location; if unknown, distance & direction from nearest town or intersection: If at owner's address, check here 1/2 South, 1/2 West of Kinsley

Global Positioning System (GPS) information:
 Latitude: (in decimal degrees)
 Longitude: (in decimal degrees)
 Elevation:
 Datum: WGS 84, NAD 83, NAD 27
 Collection Method:
 GPS unit (Make/Model:)
 Digital Map/Photo, Topographic Map, Land Survey
 Est. Accuracy: <3 m, 3-5 m, 5-15 m, >15 m

2 WATER WELL OWNER: James Habiger
 RR#, Street Address, Box #: 1167 70th Avenue
 City, State, ZIP Code : Kinslev, KS 67547

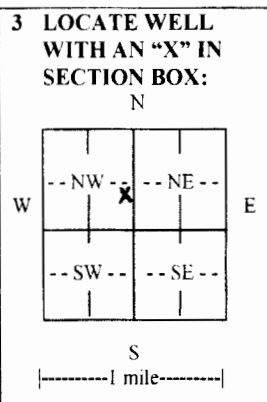

4 DEPTH OF COMPLETED WELL 130 ft.

Depth(s) Groundwater Encountered (1)..... ft. (2)..... ft. (3)..... ft.
 WELL'S STATIC WATER LEVEL 20 ft. below land surface measured on mo/day/yr. 12-3-14
 Pump test data: Well water was 84 ft. after 3 hours pumping. 200 gpm
 EST. YIELD. 249 gpm. Well water was 114 ft. after 3 1/2 hours pumping. 249 gpm
 Bore Hole Diameter 30 in. to 130 ft., and in. to ft.
 WELL WATER TO BE USED AS: Public water supply Geothermal Injection well
 Domestic Feedlot Oil field water supply Dewatering Other (Specify below)
 Irrigation Industrial Domestic-lawn & garden Monitoring well
 Was a chemical/bacteriological sample submitted to Department? Yes No
 If yes, mo/day/yr sample was submitted.....
 Water well disinfected? Yes No

5 TYPE OF CASING USED: Steel PVC Other

CASING JOINTS: Glued Clamped Welded Threaded
 Casing diameter .16 in. to 130 ft., Diameter in. to ft., Diameter in. to ft.
 Casing height above land surface 18 in., Weight Sch 40 lbs./ft., Wall thickness or gauge No.
 TYPE OF SCREEN OR PERFORATION MATERIAL:
 Steel Stainless Steel PVC Other (Specify)
 Brass Galvanized Steel None used (open hole)
 SCREEN OR PERFORATION OPENINGS ARE:
 Continuous slot Mill slot Gauze wrapped Torch cut Drilled holes None (open hole)
 Louvered shutter Key punched Wire wrapped Saw cut Other (specify)
 SCREEN-PERFORATED INTERVALS: From 130 ft. to 97 ft., From ft. to ft.
 GRAVEL PACK INTERVALS: From 130 ft. to 20 ft., From ft. to ft.
 From ft. to ft., From ft. to ft.

6 GROUT MATERIAL: Neat cement Cement grout Bentonite Other

Grout Intervals: From ft. to ft., From 20 ft. to 0 ft., From ft. to ft.

What is the nearest source of possible contamination:
 Septic tank Lateral lines Pit privy Livestock pens Insecticide storage Other (specify below)
 Sewer lines Cesspool Sewage lagoon Fuel storage Abandoned water well
 Watertight sewer lines Seepage pit Feedyard Fertilizer storage Oil well/gas well None
 Direction from well Distance from well

FROM	TO	LITHOLOGIC LOG	FROM	TO	LITHO. LOG (cont.) or PLUGGING INTERVALS
0	3	Top soil			
3	7	Clay			
7	24	Pea gravel			
24	24.5	Clay			
24.5	28	Sand & gravel			
28	46	Clay			
46	83	Black clay			
83	100	Fine sand & clay mixed			
100	123	Sand w/ some gravel			
123	130	Fire clay			

7 CONTRACTOR'S OR LANDOWNER'S CERTIFICATION: This water well was constructed, reconstructed, or plugged under my jurisdiction and was completed on (mo/day/year) 12-8-14 and this record is true to the best of my knowledge and belief. Kansas Water Well Contractor's License No. 134. This Water Well Record was completed on (mo/day/year) 12-15-14 under the business name of Rosencrantz-Bemis Ent Inc by (signature) Jana Alajo

INSTRUCTIONS: Use typewriter or ball point pen. PLEASE PRESS FIRMLY and PRINT clearly. Please fill in blanks and check the correct answers. Send three copies (white, blue, pink) to Kansas Department of Health and Environment, Bureau of Water, Geology Section, 1000 SW Jackson St., Suite 420, Topeka, Kansas 66612-1367. Telephone 785-296-5524. Send one copy to WATER WELL OWNER and retain one for your records. Include fee of \$5.00 for each constructed well. Visit us at <http://www.kdheks.gov/waterwell/index.html>.