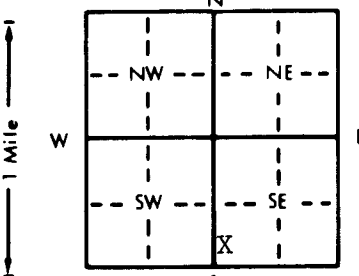


1 LOCATION OF WATER WELL:	Fraction	Section Number	Township Number	Range Number
County: SEDGWICK	SW 1/4 SW 1/4 SE 1/4	3	T 25 S	R 2 E/W

Distance and direction from nearest town or city street address of well if located within city?

SEE BELOW

2 WATER WELL OWNER: SUE OXENDINE	Board of Agriculture, Division of Water Resources
RR#, St. Address, Box #: 15722 W. 117th NORTH	Application Number:
City, State, ZIP Code: SEDGWICK, KS 67135	

3 LOCATE WELL'S LOCATION WITH AN "X" IN SECTION BOX:	4 DEPTH OF COMPLETED WELL: 42 ft. ELEVATION:
	Depth(s) Groundwater Encountered 1. ft. 2. ft. 3. ft.
	WELL'S STATIC WATER LEVEL 16 ft. below land surface measured on mo/day/yr 5-20-96
	Pump test data: Well water was ft. after hours pumping gpm
	Est. Yield 25 gpm: Well water was ft. after hours pumping gpm
	Bore Hole Diameter 11 in. to 42 in. to ft.
	WELL WATER TO BE USED AS:
	Domestic 3 Feedlot 6 Oil field water supply 9 Dewatering 12 Other (Specify below)
	2 Irrigation 4 Industrial 7 Lawn and garden only 10 Monitoring well
	Was a chemical/bacteriological sample submitted to Department? Yes No X; If yes, mo/day/yr sample was submitted
	Water Well Disinfected? Yes X No

5 TYPE OF BLANK CASING USED:	5 Wrought iron	8 Concrete tile	CASING JOINTS: Glued X Clamped
1 Steel	3 RMP (SR)	6 Asbestos-Cement	9 Other (specify below)
2 PVC	4 ABS	7 Fiberglass	10 Asbestos-cement
Blank casing diameter 5 in. to 30 in. to ft.			11 Other (specify)
Casing height above land surface 12 in. weight 2.60 lbs./ft. Wall thickness or gauge No. 160 PSI			12 None used (open hole)
TYPE OF SCREEN OR PERFORATION MATERIAL:			
1 Steel	3 Stainless steel	5 Fiberglass	8 RMP (SR)
2 Brass	4 Galvanized steel	6 Concrete tile	9 ABS
SCREEN OR PERFORATION OPENINGS ARE:			
1 Continuous slot	3 Mill slot	5 Gauzed wrapped	8 Saw cut
2 Louvered shutter	4 Key punched	6 Wire wrapped	9 Drilled holes
SCREEN-PERFORATED INTERVALS:			
From 30 ft. to 42 ft.			
GRAVEL PACK INTERVALS:			
From 20 ft. to 42 ft.			

6 GROUT MATERIAL:	2 Neat cement	2 Cement grout	3 Bentonite	4 Other
Grout Intervals: From 2 ft. to 20 ft.				
What is the nearest source of possible contamination:				
1 Septic tank	4 Lateral lines	7 Pit privy	10 Livestock pens	14 Abandoned water well
2 Sewer lines	5 Cess pool	8 Sewage lagoon	11 Fuel storage	15 Oil well/Gas well
3 Watertight sewer lines	6 Seepage pit	9 Feedyard	12 Fertilizer storage	16 Other (specify below)
Direction from well? NORTH				

FROM	TO	LITHOLOGIC LOG	FROM	TO	PLUGGING INTERVALS
0	2	TOP SOIL			
2	12	CLAY			
12	23	FINE SAND			
23	24	CLAY			
24	42	MEDIUM SAND			

7 CONTRACTOR'S OR LANDOWNER'S CERTIFICATION: This water well was (1) constructed, (2) reconstructed, or (3) plugged under my jurisdiction and was completed on (mo/day/year) 5-20-96 and this record is true to the best of my knowledge and belief. Kansas Water Well Contractor's License No. 318 This Water Well Record was completed on (mo/day/yr) 5-21-96 under the business name of WENINGER DRILLING, INC by (signature) Karina J. Brasser
--