WATER WELL RECORD Form WWC-5 KSA 82a-1212 ID No. _____

1 LOCATION OF WATER WELL: County: Sedgwick	Fraction: SE ¼ NE ¼ NE ¼	Section Number: 13	Township Number: T 25 (S)	Range Number: R 2 (E/W)

Distance and direction from nearest town or city street address of well if located within city?
13711 W. 105th St. Bentley

2 WATER WELL OWNER: Malone Const.
RR#, St. Address, Box # : 13711 W. 105th St.
City, State, ZIP Code : Bentley, Ks 67016

Board of Agriculture, Division of Water Resources Application Number:

3 LOCATE WELL'S LOCATION WITH AN "X" IN SECTION BOX:

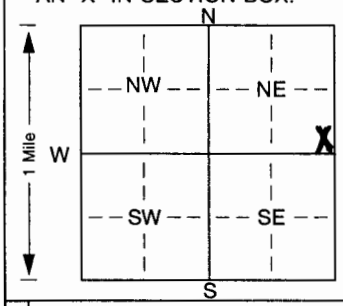

4 DEPTH OF COMPLETED WELL 40 ft. ELEVATION:
Depth(s) Groundwater Encountered 1 ft. 2. ft. 3. ft.
WELL'S STATIC WATER LEVEL 14 ft. below land surface measured on mo/day/yr 10/26/05
Pump test data: Well water was ft. after hours pumping gpm
Est. Yield gpm: Well water was ft. after hours pumping gpm
Bore Hole Diameter in. to ft., and in. to ft.
WELL WATER TO BE USED AS: 1 Domestic 3 Feedlot 5 Public water supply 6 Oil field water supply 7 Domestic (lawn & garden) 8 Air conditioning 9 Dewatering 10 Monitoring well 11 Injection well 12 Other (Specify below) 2 Irrigation 4 Industrial
Was a chemical/bacteriological sample submitted to Department? Yes No ✓; If yes, mo/day/yrs sample was submitted
Water Well Disinfected? Yes ✓ No

5 TYPE OF BLANK CASING USED: 1 Steel 3 RMP (SR) 5 Wrought iron 6 Asbestos-Cement 8 Concrete tile 9 Other (specify below) 2 PVC 4 ABS 7 Fiberglass
CASING JOINTS: Glued ✓ Clamped Welded Threaded
Blank casing diameter 5 in. to 40 ft., Dia in. to ft., Dia in. to ft.
Casing height above land surface 16 in., weight 160 lbs./ft. Wall thickness or gauge No. 26
TYPE OF SCREEN OR PERFORATION MATERIAL: 1 Steel 3 Stainless steel 5 Fiberglass 8 RMP (SR) 10 Asbestos-cement 2 Brass 4 Galvanized steel 6 Concrete tile 9 ABS PVC 11 Other (specify) 12 None used (open hole)
SCREEN OR PERFORATION OPENINGS ARE: 1 Continuous slot 3 Mill slot 5 Gauzed wrapped 6 Wire wrapped 8 Saw cut 9 Drilled holes 11 None (open hole) 2 Louvered shutter 4 Key punched 7 Torch cut 10 Other (specify) ft.
SCREEN-PERFORATED INTERVALS: From 30 ft. to 40 ft., From ft. to ft.
From ft. to ft., From ft. to ft.
GRAVEL PACK INTERVALS: From 24 ft. to 40 ft., From ft. to ft.
From ft. to ft., From ft. to ft.

6 GROUT MATERIAL: 1 Neat cement 2 Cement grout 3 Bentonite 4 Other
Grout Intervals: From 4 ft. to 24 ft., From ft. to ft., From ft. to ft.
What is the nearest source of possible contamination: 1 Septic tank 4 Lateral lines 7 Pit privy 10 Livestock pens 14 Abandoned water well 2 Sewer lines 5 Cess pool 8 Sewage lagoon 11 Fuel storage 15 Oil well/Gas well 3 Watertight sewer lines 6 Seepage pit 9 Feedyard 12 Fertilizer storage 16 Other (specify below) 13 Insecticide storage
Direction from well? South How many feet? 70'

FROM	TO	LITHOLOGIC LOG	FROM	TO	PLUGGING INTERVALS
0	2	Top Soil			
2	14	Clay			
14	33	Med Sand			
33	40	Course Sand-gravel			

7 CONTRACTOR'S OR LANDOWNER'S CERTIFICATION: This water well was (1) constructed, (2) reconstructed, or (3) plugged under my jurisdiction and was completed on (mo/day/year) 10/26/05 and this record is true to the best of my knowledge and belief. Kansas Water Well Contractor's Licence No. 611 This Water Well Record was completed on (mo/day/yr) 11/15/05 under the business name of Chase Drilling by (signature) D Chase

INSTRUCTIONS: Use typewriter or ball point pen. *PLEASE PRESS FIRMLY* and *PRINT* clearly. Please fill in blanks, underline or circle the correct answers. Send top three copies to Kansas Department of Health and Environment, Bureau of Water, Topeka, Kansas 66620-0001. Telephone 785-296-5524. Send one to WATER WELL OWNER and retain one for your records. Fee of $5.00 for each constructed well.