

WATER WELL PLUGGING RECORD Form WWC-5R

KSA 82a-1212

ID NO.


1 LOCATION OF WATER WELL:	Fraction	Section Number	Township Number	Range Number
County: <u>Sedgwick</u>	<u>SE 1/4 NE 1/4</u>	<u>12</u>	<u>25</u>	<u>2</u> XX

Distance and direction from nearest town or city street address of well if located within city?

2 miles East & 3/4 mile North of Bentley, KS

2 WATER WELL OWNER:	Global Positioning Systems (decimal degrees, min. of 4 digits)
City of Wichita	Latitude: _____
c/o GRTI	Longitude: _____
RR#, St. Address, Box #: <u>1226 Camelot Dr.</u>	Elevation: _____
City, State ZIP Code: <u>Brookings, SD 57006</u>	Datum: _____
	Data Collection Method: _____

3 MARK WELL'S LOCATION WITH AN "X" IN SECTION BOX:

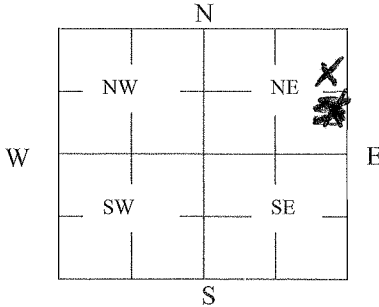

4 DEPTH OF WELL 230 ft. (1 bore)

WELL'S STATIC WATER LEVEL _____ ft

WELL WAS USED AS:

- | | | |
|--------------|----------------------------|--|
| 1 Domestic | 5 Public Water Supply | 9 Dewatering |
| 2 Irrigation | 6 Oil Field Water Supply | 10 Monitoring |
| 3 Feedlot | 7 Domestic (Lawn & Garden) | 11 Injection Well |
| 4 Industrial | 8 Air Conditioning | ☒ Other <u>Geothermal</u> |

Was a chemical/bacteriological sample submitted to Department? Yes _____ No X

5 TYPE OF BLANK CASING USED:

- | | | | | |
|---------|------------|-------------------|-----------------|--|
| 1 Steel | 3 RMP (SR) | 5 Wrought | 7 Fiberglass | ☒ Other (Specify below) _____ |
| 2 PVC | 4 ABS | 6 Asbestos-Cement | 8 Concrete Tile | <u>Polyethylene</u> |

Blank casing diameter 1 in. Was casing pulled? Yes _____ No X If yes, how much _____

Casing height above or below land surface 60 in.

6 GROUT PLUG MATERIAL: 1 Neat cement 2 Cement grout X Bentonite 4 Other _____

Grout Plug Intervals: From 0 ft. to 230 ft., From _____ ft. to _____ ft., From _____ to _____ ft.

What is the nearest source of possible contamination: None within 1/4 mile

- | | | | |
|--------------------------|-------------------|-------------------------|--------------------------------|
| 1 Septic tank | 6 Seepage pit | 11 Fuel Storage | 16 Other (specify below) _____ |
| 2 Sewer lines | 7 Pit privy | 12 Fertilizer storage | _____ |
| 3 Watertight sewer lines | 8 Sewage lagoon | 13 Insecticide storage | _____ |
| 4 Lateral lines | 9 Feedyard | 14 Abandoned water well | Direction from well? _____ |
| 5 Cess pool | 10 Livestock pens | 15 Oil well/Gas well | How many feet? _____ |

FROM	TO	PLUGGING MATERIALS	FROM	TO	PLUGGING MATERIALS
0	3	Topsoil	98	189	Sand, fine to medium
3	7	Clay, brown			w/clay layers
7	15	Sand & gravel - Coarse	189	300	Shale, gray w/hard layers
15	75	Sand, medium to coarse			
75	78	Clay, brown			
78	82	Sand, medium w/ clay layers			
82	98	Clay, gray			

7 CONTRACTOR'S OR LANDOWNER'S CERTIFICATION: This water well was plugged under my jurisdiction and was completed on (mo/day/year) 2/17/10 and this record is true to the best of my knowledge and belief. Kansas Water Well Contractor's License No. 138. This Water Well Record was completed on (mo/day/year) 2/22/10 under the business name of Peterson Irrigation, Inc. by (signature) Mike Peterson

INSTRUCTIONS: Use typewriter or ballpoint pen. Please press firmly and print clearly. Please fill in blanks, underline or circle the correct answers. Send top three copies to Kansas Department of Health and Environment, Bureau of Water, Geology Section, 1000 SW Jackson St., Ste. 420, Topeka, Kansas 66612-1367. Telephone: 785/296-5522. Send one to Water Well Owner and retain one for your records. Visit us at <http://www.kdheks.gov/geo/waterwells>.