

WATER WELL PLUGGING RECORD Form WWC-5P

KSA 82a-1212

ID NO.

28743 & 32784

1 LOCATION OF WATER WELL: Fraction $\frac{1}{4}$ NC $\frac{1}{4}$ NS $\frac{1}{4}$ SE $\frac{1}{4}$ Section Number 15 Township Number T 25 S Range Number 2 ☐ E ☒ W
County: Sedgwick

Street/Rural Address of Well Location; if unknown, distance & direction from nearest town or intersection: If at owner's address, check here ☐ approximately 0.5 miles south and

0.25 miles west of Bentley, KS

Global Positioning Systems (GPS) information:

Latitude: 37.87603 (in decimal degrees)

Longitude: -97.52326 (in decimal degrees)

Elevation:

Datum: ☐ WGS84, ☐ NAD83, ☒ NAD27

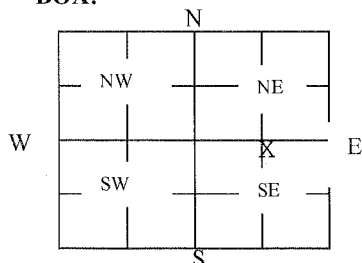
Collection Method:

☒ GPS unit (Make/Model: Garmin GPSmap 60CSx

☐ Digital Map/Photo, ☐ Topographic Map, ☐ Land Survey

Est. Accuracy: ☐ < 3 m, ☒ 3-5 m, ☐ 5-15 m, ☐ > 15 m

2 WATER WELL OWNER: Carolyn Foutch Rev Trust
RR#, St. Address, Box #: 14830 Highland Park Road
City, State ZIP Code: Council Bluffs, IA 51503

3 MARK WELL'S LOCATION WITH AN "X" IN SECTION BOX:**4 DEPTH OF WELL** 43 **ft.**

WELL'S STATIC WATER LEVEL 10 **ft**

WELL WAS USED AS:

☐ Domestic
☒ Irrigation
☐ Feedlot
☐ Industrial

☐ Public Water Supply
☐ Oil Field Water Supply
☐ Domestic (Lawn & Garden)
☐ Air Conditioning

☐ Dewatering
☐ Monitoring
☐ Injection Well
☐ Other

Was a chemical/bacteriological sample submitted to Department? Yes ☐ No ☒

5 TYPE OF BLANK CASING USED:

☐ Steel
☐ PVC

☐ RMP (SR)
☐ ABS

☐ Wrought
☒ Asbestos-Cement

☐ Fiberglass
☐ Concrete Tile

☐ Other (Specify below)

Blank casing diameter 16 in. Was casing pulled? Yes ☐ No ☒ If yes, how much _____
Casing height above or below land surface below 36 in.

6 GROUT PLUG MATERIAL: ☐ Neat cement ☒ Cement grout ☐ Bentonite ☐ Other

Grout Plug Intervals: From 10 ft. to 3 ft., From _____ ft. to _____ ft., From _____ to _____ ft.

What is the nearest source of possible contamination:

☐ Septic tank
☐ Sewer lines
☐ Watertight sewer lines
☐ Lateral lines
☐ Cess pool

☐ Seepage pit
☐ Pit privy
☐ Sewage lagoon
☐ Feedyard
☐ Livestock pens

☒ Fuel Storage
☐ Fertilizer storage
☐ Insecticide storage
☐ Abandoned water well
☐ Oil well/Gas well

☐ Other (specify below)

Direction from well? West

How many feet? approximately 1270 ft.

FROM	TO	PLUGGING MATERIALS	FROM	TO	PLUGGING MATERIALS
43	10	Clean, coarse sand			Well plugging witnessed by
10	3	Cement grout			D. Randolph, GMD2 staff, on 1-27-12
3	0	Topsoil			and 1-30-12

7 CONTRACTOR'S OR LANDOWNER'S CERTIFICATION: This water well was plugged under my jurisdiction and was completed on (mo/day/year) 1-30-2012 and this record is true to the best of my knowledge and belief. Kansas Water Well Contractor's License No. _____. This Water Well Record was completed on (mo/day/year) 1-30-2012 under the business name of Carolyn Foutch Rev trust by (signature) Carolyn Foutch

INSTRUCTIONS: Use typewriter or ballpoint pen. Please press firmly and print clearly. Please fill in blanks, underline or circle the correct answers. Send top three copies to Kansas Department of Health and Environment, Bureau of Water, Geology Section, 1000 SW Jackson St., Ste. 420, Topeka, Kansas 66612-1367. Telephone: 785/296-5524. Send one to Water Well Owner and retain one for your records. Visit us at <http://www.kdheks.gov/waterwell/index.html>

Check one:

☐ White Copy ☐ Blue Copy ☐ Pink Copy

FEB 23 2012

FEB 13 2012

BUREAU OF WATER

Equus Beds Groundwater
Management District No. 2