

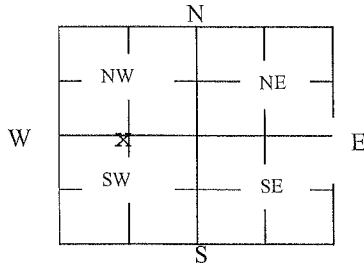
WATER WELL PLUGGING RECORD Form WWC-5P

KSA 82a-1212

ID NO.

22900

1 LOCATION OF WATER WELL: County: Sedgwick	Fraction $\frac{1}{4}$ $\frac{1}{4}$ NC $\frac{1}{4}$ WS $\frac{1}{4}$	Section Number 25	Township Number T 25 S	Range Number 2 ☐ E ☒ W
Street/Rural Address of Well Location; if unknown, distance & direction from nearest town or intersection: If at owner's address, check here ☐ Approximately 1 mile east and 2.5 miles south of Bentley, KS		Global Positioning Systems (GPS) information: Latitude: 37.84689 (in decimal degrees) Longitude: 97.49561 (in decimal degrees) Elevation: Datum: ☐ WGS84, ☐ NAD83, ☒ NAD27 Collection Method: ☒ GPS unit (Make/Model: Garmin GPSmap 60CSx) ☐ Digital Map/Photo, ☐ Topographic Map, ☐ Land Survey Est. Accuracy: ☐ < 3 m, ☒ 3-5 m, ☐ 5-15 m, ☐ > 15 m		
2 WATER WELL OWNER: Hohman Land Co. RR#, St. Address, Box #: 1725 Krameria St. City, State ZIP Code: Denver, CO 80220				

3 MARK WELL'S LOCATION WITH AN "X" IN SECTION BOX:**4 DEPTH OF WELL** 33 **ft.**

WELL'S STATIC WATER LEVEL 11 ft

WELL WAS USED AS:

- ☐
- Domestic
-
- ☒
- Irrigation
-
- ☐
- Feedlot
-
- ☐
- Industrial

- ☐
- Public Water Supply
-
- ☐
- Oil Field Water Supply
-
- ☐
- Domestic (Lawn & Garden)
-
- ☐
- Air Conditioning

- ☐
- Dewatering
-
- ☐
- Monitoring
-
- ☐
- Injection Well
-
- ☐
- Other

Was a chemical/bacteriological sample submitted to Department? Yes ☐ No ☒**5 TYPE OF BLANK CASING USED:**

- ☒
- Steel
- ☐
- RMP (SR)
- ☐
- Wrought
- ☐
- Fiberglass
- ☐
- Other (Specify below)
-
- ☐
- PVC
- ☐
- ABS
- ☐
- Asbestos-Cement
- ☐
- Concrete Tile

 Blank casing diameter 10 in. Was casing pulled? Yes ☐ No ☒ If yes, how much _____
 Casing height above or below land surface below 60 in.
6 GROUT PLUG MATERIAL: ☐ Neat cement ☐ Cement grout ☒ Bentonite ☐ Other

Grout Plug Intervals: From 15 ft. to 5 ft., From _____ ft. to _____ ft., From _____ to _____ ft.

What is the nearest source of possible contamination:

- | | | | |
|---|---|--|--|
| ☐ Septic tank | ☐ Seepage pit | ☒ Fuel Storage | ☐ Other (specify below) |
| ☐ Sewer lines | ☐ Pit privy | ☐ Fertilizer storage | |
| ☐ Watertight sewer lines | ☐ Sewage lagoon | ☐ Insecticide storage | |
| ☐ Lateral lines | ☐ Feedyard | ☐ Abandoned water well | |
| ☐ Cess pool | ☐ Livestock pens | ☐ Oil well/Gas well | |

 Direction from well? West
 How many feet? Approximately 1280 ft.

FROM	TO	PLUGGING MATERIALS	FROM	TO	PLUGGING MATERIALS
33'	15'	Clean, coarse sand			Well plugging witnessed by
15'	5'	Bentonite hole plug			D. Randolph, GMD2 staff, on
5'	0	Topsoil			RECEIVED 8-30-12
					RECEIVED
					JUN 19 2012
					JUN 11 2012
					BUREAU OF WATER

7 CONTRACTOR'S OR LANDOWNER'S CERTIFICATION: This water well was plugged under my jurisdiction and was completed on (mo/day/year) 3-30-12 and this record is true to the best of my knowledge and belief. Kansas Water Well Contractor's License No. _____ This Water Well Record was completed on (mo/day/year) 4-16-12 under the business name of Hohman Land by (signature) Debra A. Willey, Manager

INSTRUCTIONS: Use typewriter or ballpoint pen. Please press firmly and print clearly. Please fill in blanks, underline or circle the correct answers. Send top three copies to Kansas Department of Health and Environment, Bureau of Water, Geology Section, 1000 SW Jackson St., Ste. 420, Topeka, Kansas 66612-1367. Telephone: 785/296-5524. Send one to Water Well Owner and retain one for your records. Visit us at <http://www.kdheks.gov/waterwell/index.html>.

Check one: ☐ White Copy ☐ Blue Copy ☐ Pink Copy