

WATER WELL PLUGGING RECORD Form WWC-5P

KSA 82a-1212

ID NO.

6629 & 32776

1 LOCATION OF WATER WELL: County: Sedgwick	Fraction ¼ NE ¼ NE ¼ SE ¼	Section Number 22	Township Number T 25 S	Range Number 2 ☐ E ☒ W
---	------------------------------	----------------------	---------------------------	--

Street/Rural Address of Well Location; if unknown, distance & direction from nearest town or intersection: If at owner's address, check here ☐ Approximately 1.5 miles south of

Bentley, KS

Global Positioning Systems (GPS) information:

Latitude: 37.86021 (in decimal degrees)

Longitude: -97.51880 (in decimal degrees)

Elevation:

Datum: ☐ WGS84, ☐ NAD83, ☒ NAD27

Collection Method:


☒ GPS unit (Make/Model: Garmin GPSmap 60CSx

☐ Digital Map/Photo, ☐ Topographic Map, ☐ Land Survey

Est. Accuracy: ☐ < 3 m, ☒ 3-5 m, ☐ 5-15 m, ☐ > 15 m

2 WATER WELL OWNER: David R Jacob Rev Trust
RR#, St. Address, Box #: PO Box 81
City, State ZIP Code: Bentley, KS 67016

3 MARK WELL'S LOCATION WITH AN "X" IN SECTION BOX:

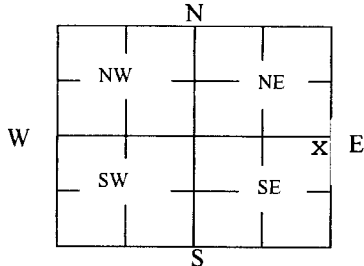

4 DEPTH OF WELL 32 ft.

WELL'S STATIC WATER LEVEL 9.5 ft

WELL WAS USED AS:

☐ Domestic
☒ Irrigation
☐ Feedlot
☐ Industrial

☐ Public Water Supply
☐ Oil Field Water Supply
☐ Domestic (Lawn & Garden)
☐ Air Conditioning

☐ Dewatering
☐ Monitoring
☐ Injection Well
☐ Other

Was a chemical/bacteriological sample submitted to Department? Yes ☐ No ☒

5 TYPE OF BLANK CASING USED:

☒ Steel ☐ RMP (SR) ☐ Wrought ☐ Fiberglass ☐ Other (Specify below)
☐ PVC ☐ ABS ☐ Asbestos-Cement ☐ Concrete Tile

Blank casing diameter 6 in. Was casing pulled? Yes ☐ No ☒ If yes, how much
Casing height above or below land surface below 36 in.

6 GROUT PLUG MATERIAL: ☐ Neat cement ☒ Cement grout ☐ Bentonite ☐ Other

Grout Plug Intervals: From 13 ft. to 3 ft., From _____ ft. to _____ ft., From _____ to _____ ft.

What is the nearest source of possible contamination:

☐ Septic tank ☐ Seepage pit ☒ Fuel Storage ☐ Other (specify below)
☐ Sewer lines ☐ Pit privy ☐ Fertilizer storage
☐ Watertight sewer lines ☐ Sewage lagoon ☐ Insecticide storage
☐ Lateral lines ☐ Feedyard ☐ Abandoned water well Direction from well? northwest
☐ Cess pool ☐ Livestock pens ☐ Oil well/Gas well How many feet? approx. 220 ft.

FROM	TO	PLUGGING MATERIALS	FROM	TO	PLUGGING MATERIALS
32	13	Clean, coarse sand			Well plugging witnessed by
13	3	Cement grout			D. Randolph, GMD2 staff,
3	0	Topsoil			on 3/18/2014

7 CONTRACTOR'S OR LANDOWNER'S CERTIFICATION: This water well was plugged under my jurisdiction and was completed on (mo/day/year) 3/18/2014 and this record is true to the best of my knowledge and belief. Kansas Water Well Contractor's License No. _____. This Water Well Record was completed on (mo/day/year) 4/8/2014 under the business name of _____ by (signature) David Jacob

INSTRUCTIONS: Use typewriter or ballpoint pen. Please press firmly and print clearly. Please fill in blanks, underline or circle the correct answers. Send one copy to Kansas Department of Health and Environment, Bureau of Water, Geology Section, 1000 SW Jackson St., Ste. 420, Topeka, Kansas 66612-1367. Telephone: 785/296-5524. Send one to Water Well Owner and retain one for your records. Visit us at <http://www.kdheks.gov/waterwell/index.html>.

RECEIVED

APR 25 2014

Equus Beds Groundwater
Management District No. 2