

WATER WELL PLUGGING RECORD Form WWC-5P

KSA 82a-1212

ID NO.

14907

1 LOCATION OF WATER WELL: County: Sedgwick	Fraction ¼ ¼ NC ¼ SW ¼	Section Number 9	Township Number T 25 S	Range Number 2 ☐ E ☒ W
---	---------------------------	---------------------	---------------------------	--

Street/Rural Address of Well Location; if unknown, distance & direction from nearest town or intersection: If at owner's address, check here ☐ Located approximately 1.75 miles west of Bentley, KS


Global Positioning Systems (GPS) information:

Latitude: 37.88681 (in decimal degrees)
 Longitude: -97.55031 (in decimal degrees)
 Elevation:
 Horizontal Datum: ☐ WGS84, ☐ NAD83, ☒ NAD27
 Collection Method:

2 WATER WELL OWNER: Loyd Farms LP
 RR#, St. Address, Box #: PO Box 379
 City, State ZIP Code: Sedgwick, KS 67135

☒ GPS unit (Make/Model: Garmin GPSmap 60CSx)
☐ Digital Map/Photo, ☐ Topographic Map, ☐ Land Survey
 Est. Accuracy: ☐ < 3 m, ☒ 3-5 m, ☐ 5-15 m, ☐ > 15 m

3 MARK WELL'S LOCATION WITH AN "X" IN SECTION BOX:

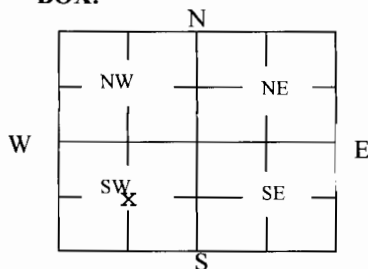

4 DEPTH OF WELL 37 ft.

WELL'S STATIC WATER LEVEL 6.2 ft

WELL WAS USED AS:

- | | | |
|--|---|---|
| ☒ Domestic | ☐ Public Water Supply | ☐ Dewatering |
| ☐ Irrigation | ☐ Oil Field Water Supply | ☐ Monitoring |
| ☐ Feedlot | ☐ Domestic (Lawn & Garden) | ☐ Injection Well |
| ☐ Industrial | ☐ Air Conditioning | ☐ Other |

Was a chemical/bacteriological sample submitted to Department? Yes ☐ No ☒

5 TYPE OF BLANK CASING USED:

- ☐ Steel ☐ RMP (SR) ☐ Wrought ☐ Fiberglass ☐ Other (Specify below)
☒ PVC ☐ ABS ☐ Asbestos-Cement ☐ Concrete Tile

Blank casing diameter 8 in. Was casing pulled? Yes ☐ No ☒ If yes, how much _____
 Casing height above or below land surface below 36 in.

6 GROUT PLUG MATERIAL:

- ☐ Neat cement ☐ Cement grout ☒ Bentonite ☐ Other _____

Grout Plug Intervals: From 13 ft. to 3 ft., From _____ ft. to _____ ft., From _____ ft. to _____ ft.

What is the nearest source of possible contamination:

- | | | | |
|---|---|--|--|
| ☐ Septic tank | ☐ Seepage pit | ☒ Fuel storage | ☐ Other (specify below) |
| ☐ Sewer lines | ☐ Pit privy | ☐ Fertilizer storage | |
| ☐ Watertight sewer lines | ☐ Sewage lagoon | ☐ Insecticide storage | |
| ☐ Lateral lines | ☐ Feedyard | ☐ Abandoned water well | Direction from well? northeast |
| ☐ Cess pool | ☐ Livestock pens | ☐ Oil well/Gas well | How many feet? approximately 15 feet |

FROM	TO	PLUGGING MATERIALS	FROM	TO	PLUGGING MATERIALS
37	13	Clean, coarse sand			Well plugging witnessed by
13	3	Bentonite Hole Plug			D. Randolph, GMD2 staff,
3	0	Topsoil			on 12/12/2016.

7 CONTRACTOR'S OR LANDOWNER'S CERTIFICATION: This water well was plugged under my jurisdiction and was completed on (mo/day/year) 12/12/2016 and this record is true to the best of my knowledge and belief. Kansas Water Well Contractor's License No. _____. This Water Well Record was completed on (mo/day/year) 12/20/2016 under the business name of _____ by (signature) *James Loyd for Loyd Farms*

Send one white copy to Kansas Department of Health & Environment, Geology Section, 1000 SW Jackson Street, Ste. 420, Topeka, KS 66612-1367. Send one copy to WATER WELL OWNER and retain one for your records.

Visit us at <http://www.kdheks.gov/waterwell/index.html> Telephone 785-296-5524.

JAN 3 2017

KSA82a-1212

Revised 1/20/2015