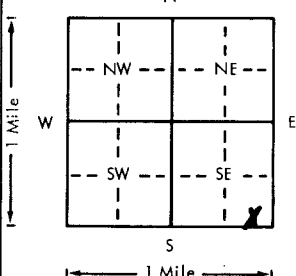
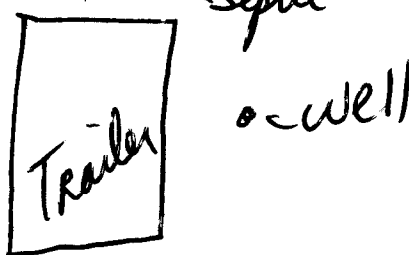


USE TYPEWRITER OR BALL
POINT PEN-PRESS FIRMLY,
PRINT CLEARLY.

WATER WELL RECORD
KSA 82a-1201-1215

Kansas Department of Health and
Environment-Division of Environment
(Water well Contractors)
Topeka, Kansas 66620

1. Location of well: County <u>Sedgwick</u> Fraction <u>SE 1/4 SE 1/4 SE 1/4</u> Section number <u>3</u> Township number <u>T 25 S</u> Range number <u>R 2 E</u>													
2. Distance and direction from nearest town or city: <u>1/2 mile NW Bentley KS</u> Street address of well location if in city:													
3. Owner of well: <u>Jerry Majors</u> R.R. or street: <u>1915 W. Main Hwy Rt 78</u> City, state, zip code: <u>Wichita KS 67208</u>													
4. Locate with "X" in section below: 													
Sketch map: <u>Septic well</u> 													
5. Type and color of material													
<table border="1"> <thead> <tr> <th></th> <th>From</th> <th>To</th> </tr> </thead> <tbody> <tr> <td><u>Top soil</u></td> <td><u>0</u></td> <td><u>2</u></td> </tr> <tr> <td><u>gray clay</u></td> <td><u>2</u></td> <td><u>13</u></td> </tr> <tr> <td><u>med. sand</u></td> <td><u>13</u></td> <td><u>40</u></td> </tr> </tbody> </table>			From	To	<u>Top soil</u>	<u>0</u>	<u>2</u>	<u>gray clay</u>	<u>2</u>	<u>13</u>	<u>med. sand</u>	<u>13</u>	<u>40</u>
	From	To											
<u>Top soil</u>	<u>0</u>	<u>2</u>											
<u>gray clay</u>	<u>2</u>	<u>13</u>											
<u>med. sand</u>	<u>13</u>	<u>40</u>											
6. Bore hole dia. <u>4</u> in. Completion date <u>5/3/78</u> Well depth <u>40</u> ft.													
7. ☒ Cable tool ☒ Rotary ☐ Driven ☐ Dug ☐ Hollow rod ☐ Jetted ☐ Bored ☐ Reverse rotary													
8. Use: ☒ Domestic ☐ Public supply ☐ Industry ☐ Irrigation ☐ Air conditioning ☐ Stock ☐ Lawn ☐ Oil field water ☐ Other													
9. Casing: Material <u>Steel</u> Weight: Above or below Threaded ☐ Welded ☒ Surface <u>1 1/2</u> in. RMP ☒ PVC ☐ Weight <u>1.50</u> lbs./ft. Dia. <u>5</u> in. to <u>40</u> ft. depth Wall Thickness: inches or Dia. <u>5</u> in. to <u>40</u> ft. depth gage No. <u>1200</u>													
10. Screen: Manufacturer's name <u>Sunflower</u> Type <u>200</u> Dia. <u>1 1/2</u> in. Slot/gauze <u>1/16</u> Length <u>10</u> ft. Set between <u>38</u> ft. and <u>40</u> ft. Gravel pack <u>yes</u> Size range of material <u>3/8</u>													
11. Static water level: <u>13</u> ft. below land surface Date <u>5/3/78</u>													
12. Pumping level below land surfaces: <u>14</u> ft. after <u>1/2</u> hrs. pumping <u>20</u> g.p.m. <u>17</u> ft. after <u>1</u> hrs. pumping <u>90</u> g.p.m. Estimated maximum yield <u>90</u> g.p.m.													
13. Water sample submitted: <u>no.</u> /day/yr. ☐ Yes ☒ No Date <u>5/3/78</u>													
14. Well head completion: ☐ Pitless adapter <u>12</u> inches above grade													
15. Well grouted? <u>yes</u> With: ☐ Neat cement ☐ Bentonite ☒ Concrete Depth: From <u>31</u> ft. to <u>13</u> ft.													
16. Nearest source of possible contamination: fr. <u>60</u> Direction <u>NW</u> Type <u>Septic</u> Well disinfected upon completion? ☒ Yes ☐ No													
17. Pump: Manufacturer's name <u>Supers</u> Model number <u>27</u> HP <u>3/8</u> Volts <u>115</u> Length of drop pipe <u>27</u> ft. capacity <u>3/8</u> g.p.m. Type: ☒ Submersible ☐ Turbine ☒ Jet ☐ Reciprocating ☐ Centrifugal ☐ Other													
20. Water well contractor's certification: This well was drilled under my jurisdiction and this report is true to the best of my knowledge and belief. Business name <u>Wichita Valley</u> License No. <u>318</u> Address <u>Edgemoor</u> Signed <u>Jerry L. Majors</u> Date <u>5/3/78</u> Authorized representative													
18. Elevation: Topography: ☐ Hill ☒ Slope ☐ Upland ☐ Valley	19. Remarks: <u>Customer to furnish 4'x4'x4" slab around casing at grade per State Regulations</u> <u>Signed Jerry L. Majors</u>												

Forward the white, blue and pink copies to the Department of Health and Environment

Form WWC-5