USE TYPEWRITER OR BALL POINT PEN-PRESS FIRMLY, PRINT CLEARLY.

WATER WELL RECORD
KSA 82a-1201-1215

Kansas Department of Health and Environment-Division of Environment
(Water well Contractors)
Topeka, Kansas 66620

1. Location of well:	County	Fraction	Section number	Township number	Range number
	SEDGWICK	1/4 SE 1/4 SE 1/4	5	T 25 S	R 2W E/W

2. Distance and direction from nearest town or city: 1 mile N. of Bentley, Ks. and 2¼ W, then ¼ N.
Street address of well location if in city:

3. Owner of well: Collins Dairy
R.R. or street: R. #2
City, state, zip code: Sedgwick, Kansas

4. Locate with "X" in section below:

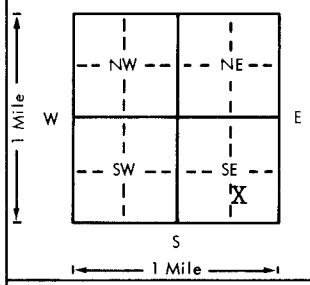

Sketch map: Bentley, Kansas

6. Bore hole dia. 11 in. Completion date
Well depth 50 ft. 7-21-78

7. __ Cable tool X Rotary __ Driven __ Dug
__ Hollow rod __ Jetted __ Bored __ Reverse rotary

8. Use: __ Domestic __ Public supply __ Industry
X Irrigation __ Air conditioning __ Stock
__ Lawn __ Oil field water __ Other

9. Casing: Material 6" Height: Above or below
Threaded __ Welded __ Surface 12 in.
RMP __ PVC X Weight 3.96 lbs./ft.
Dia. 6 in. to 50 ft. depth Wall Thickness: inches or
Dia. __ in. to __ ft. depth gage No. .316

5. Type and color of material	From	To
Sandy Topsoil	0	3
Brown Clay	3	8
Fine Sand	8	25
Coarse Sand	25	48
Brown Clay	48	50

(Use a second sheet if needed)

10. Screen: Manufacturer's name PVC NSF Approved 200 PSI
Type PVC 200 PSI Dia. 6"
Slot/gage .06 Length 20'
Set between 30 ft. and 50 ft.
ft. and ft.
Gravel pack? yes Size range of material ¼-1/8"

11. Static water level: mo./day/yr.
12 ft. below land surface Date 7-21-78

12. Pumping level below land surfaces:
ft. after hrs. pumping g.p.m.
ft. after hrs. pumping g.p.m.
Estimated maximum yield g.p.m.

13. Water sample submitted: mo./day/yr.
__ Yes __ No Date

14. Well head completion: capped
__ Pitless adapter 12 Inches above grade

15. Well grouted? yes 1-2Fine Sand Mix
With: __ Neat cement __ Bentonite X Concrete
Depth: From 0 ft. to 10 ft.

16. Nearest source of possible contamination:
ft. Direction Type NONE
Well disinfected upon completion? X Yes __ No

17. Pump: X Not installed
Manufacturer's name
Model number HP Volts
Length of drop pipe ft. capacity g.p.m.
Type:
__ Submersible __ Turbine
__ Jet __ Reciprocating
__ Centrifugal __ Other

18. Elevation:
Topography:
__ Hill
__ Slope
__ Upland
__ Valley

19. Remarks: Flat Ground
No apparent source for contamination.

20. Water well contractor's certification:
This well was drilled under my jurisdiction and this report is true to the best of my knowledge and belief.
Harp Well & Pump 236
Business name License No.
Address Wichita, Kansas 67209
Signed M. Arnold Date
Authorized representative 9-16-78

T 25 R 2W Sec 5 1/4 1/4 1/4 SE

Forward the white, blue and pink copies to the Department of Health and Environment

Form WWC-5

MI-1023