WATER WELL RECORD Form WWC-5 KSA 82a-1212

1 LOCATION OF WATER WELL:	Fraction	Section Number	Township Number	Range Number
County: Sedgwick	Near Center of ¼ ¼ SE ¼	6	T 25 S	R 2 E/W

Distance and direction from nearest town or city street address of well if located within city?
Approx. 1¼ Mi. north and 3¼ mi. west of Bentley, KS

2 WATER WELL OWNER: Randy O'Neal - c/o Virgil O'Neal
RR#, St. Address, Box # : Route 2
City, State, ZIP Code : Sedgwick, KS 67135
Board of Agriculture, Division of Water Resources Application Number: not available

3 LOCATE WELL'S LOCATION WITH AN "X" IN SECTION BOX:

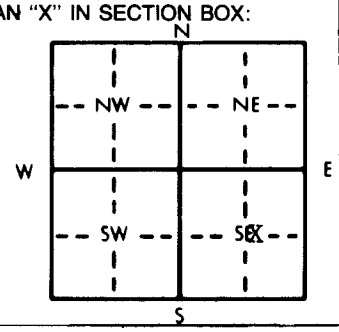

4 DEPTH OF COMPLETED WELL 58 ft. ELEVATION: unknown
Depth(s) Groundwater Encountered 1. 11.5 ft. 2. ft. 3. ft.
WELL'S STATIC WATER LEVEL 11.5 ft. below land surface measured on mo/day/yr 4/16/86
Pump test data: Well water was not ck'd. ft. after hours pumping gpm
Est. Yield 800 gpm: Well water was ft. after hours pumping gpm
Bore Hole Diameter 24 in. to 58 ft., and in. to ft.
WELL WATER TO BE USED AS: 5 Public water supply 8 Air conditioning 11 Injection well
1 Domestic 3 Feedlot 6 Oil field water supply 9 Dewatering 12 Other (Specify below)
2 Irrigation 4 Industrial 7 Lawn and garden only 10 Observation well
Was a chemical/bacteriological sample submitted to Department? Yes No X; If yes, mo/day/yr sample was submitted
Water Well Disinfected? Yes No X

5 TYPE OF BLANK CASING USED: 5 Wrought iron 8 Concrete tile CASING JOINTS: Glued Clamped
1 Steel 3 RMP (SR) 6 Asbestos-Cement 9 Other (specify below) Welded X
2 PVC 4 ABS 7 Fiberglass Threaded
Blank casing diameter 16 in. to 21 ft., Dia in. to ft., Dia in. to ft.
Casing height above land surface 12 in., weight 31.66 lbs./ft. Wall thickness or gauge No. .188
TYPE OF SCREEN OR PERFORATION MATERIAL: 7 PVC 10 Asbestos-cement
1 Steel 3 Stainless steel 5 Fiberglass 8 RMP (SR) 11 Other (specify)
2 Brass 4 Galvanized steel 6 Concrete tile 9 ABS 12 None used (open hole)
SCREEN OR PERFORATION OPENINGS ARE: 5 Gauzed wrapped 8 Saw cut 11 None (open hole)
1 Continuous slot 3 Mill slot 6 Wire wrapped 9 Drilled holes
2 Louvered shutter 4 Key punched 7 Torch cut 10 Other (specify) Doerr Bridge Slot
SCREEN-PERFORATED INTERVALS: From 21 ft. to 57 ft., From ft. to ft.
From ft. to ft., From ft. to ft.
GRAVEL PACK INTERVALS: From 10 ft. to 57 ft., From ft. to ft.
From ft. to ft., From ft. to ft.

6 GROUT MATERIAL: 1 Neat cement 2 Cement grout 3 Bentonite 4 Other
Grout Intervals: From 0 ft. to 10 ft., From ft. to ft., From ft. to ft.
What is the nearest source of possible contamination:
1 Septic tank 4 Lateral lines 7 Pit privy 10 Livestock pens 14 Abandoned water well
2 Sewer lines 5 Cess pool 8 Sewage lagoon 11 Fuel storage 15 Oil well/Gas well
3 Watertight sewer lines 6 Seepage pit 9 Feedyard 12 Fertilizer storage 16 Other (specify below) FIELD
13 Insecticide storage
Direction from well? all How many feet?

FROM	TO	LITHOLOGIC LOG	FROM	TO	LITHOLOGIC LOG
0	9	Sandy topsoil & sandy brown clay			
9	56	Sand & gravel, med. to fine to coarse			
56	60	Yellow tan clay			

7 CONTRACTOR'S OR LANDOWNER'S CERTIFICATION: This water well was (1) constructed, (2) reconstructed, or (3) plugged under my jurisdiction and was completed on (mo/day/year) 4/16/86 and this record is true to the best of my knowledge and belief. Kansas Water Well Contractor's License No. 185 This Water Well Record was completed on (mo/day/yr) 4/17/86 under the business name of Clarke Well & Equipment, Inc. by (signature)

INSTRUCTIONS: Use typewriter or ball point pen, *PLEASE PRESS FIRMLY* and *PRINT* clearly. Please fill in blanks, underline or circle the correct answers. Send top three copies to Kansas Department of Health and Environment, Division of Environment, Environmental Geology Section, Topeka, KS 66620. Send one to WATER WELL OWNER and retain one for your records.

OFFICE USE ONLY T R E/W SEC. ¼ ¼ ¼