USE TYPEWRITER OR BALL POINT PEN-PRESS FIRMLY, PRINT CLEARLY.

WATER WELL RECORD
KSA 82a-1201-1215

Kansas Department of Health and Environment-Division of Environment
(Water well Contractors)
Topeka, Kansas 66620

1. Location of well:	County	Fraction	Section number	Township number	Range number
	SEDGWICK	1/4 C 1/4 NW 1/4	7	T 25 S	R 2W E/W

2. Distance and direction from nearest town or city: 215th St. W., and 117th St. No. Bentley, Kansas
Street address of well location if in city:

3. Owner of well: John Young
R.R. or street: RFD #2
City, state, zip code: Burrton, Kansas

4. Locate with "X" in section below: Sketch map:

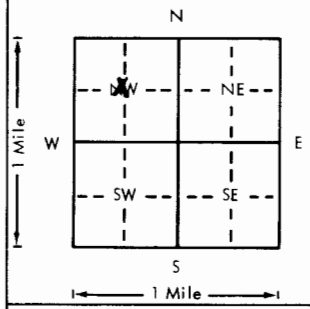

6. Bore hole dia. 30 in. Completion date
Well depth 49 ft. 6-13-78

7. ___ Cable tool ___ Rotary ___ Driven ___ Dug
___ Hollow rod ___ Jetted ___ Bored X Reverse rotary

8. Use: ___ Domestic ___ Public supply ___ Industry
X Irrigation ___ Air conditioning ___ Stock
___ Lawn ___ Oil field water ___ Other

9. Casing: Material Transite see #19 below Height: Above or below
Threaded ___ Welded ___ Surface 12 in.
RMP ___ PVC ___ Weight 37 lbs./ft.
Dia. 16 in. to 49 ft. depth Wall Thickness: inches or
Dia. ___ in. to ___ ft. depth gage No. 3/4"

5. Type and color of material	From	To
Topsoil	0	2
Clay	2	9
Medium to Coarse Sand and Gravel	9	48
Clay	48	49

(Use a second sheet if needed)

10. Screen: Manufacturer's name Johnson
Type irrigation Dia. 16"
Slot/gauze .100 Length 28'
Set between 20 ft. and 33 ft.
33 ft. and 48 ft.
Gravel pack? yes Size range of material 1/4-1/8"

11. Static water level: mo./day/yr.
10 ft. below land surface Date 6-13-78

12. Pumping level below land surfaces:
___ ft. after ___ hrs. pumping ___ g.p.m.
___ ft. after ___ hrs. pumping ___ g.p.m.
Estimated maximum yield ___ g.p.m.

13. Water sample submitted: mo./day/yr.
___ Yes ___ No Date

14. Well head completion:
___ Pitless adapter 12 Inches above grade

15. Well grouted? yes 1-2Fine Sand Mix
With: ___ Neat cement ___ Bentonite X Concrete
Depth: From 0 ft. to 10 ft.

16. Nearest source of possible contamination:
ft. ___ Direction ___ Type NONE
Well disinfected upon completion? X Yes ___ No

17. Pump: ___ Not installed
Manufacturer's name Valley
Model number 12MME HP 40 Volts N/A
Length of drop pipe 40 ft. capacity 800 g.p.m.
Type:
___ Submersible X Turbine
___ Jet ___ Reciprocating
___ Centrifugal ___ Other

18. Elevation:

Topography:
___ Hill
___ Slope
___ Upland
___ Valley

19. Remarks: Flat Ground
From #9 Above--
Banded But Joint

No apparent source for contamination.

20. Water well contractor's certification:
This well was drilled under my jurisdiction and this report is true to the best of my knowledge and belief.
Harp Well & Pump 236
Business name License No.
Address Wichita, Kansas 67209
Signed M. Arnell Date 6-30-78
Authorized representative

T 25 R 2W E Sec 7 1/4 C NW 1/4

Forward the white, blue and pink copies to the Department of Health and Environment

Form WWC-5

MI-1023