USE TYPEWRITER OR BALL POINT PEN-PRESS FIRMLY, PRINT CLEARLY.

WATER WELL RECORD
KSA 82a-1201-1215

Kansas Department of Health and Environment-Division of Environment
(Water well Contractors)
Topeka, Kansas 66620

1. Location of well:	County	Fraction	Section number	Township number	Range number
	Sedgwick	NW1/4 NW1/4 NW1/4	16	T 25 S	R 2 E (W)

2. Distance and direction from nearest town or city:
Street address of well location if in city: 1½ W Bentley

3. Owner of well: Virgil O'Neal
R.R. or street: RR 2
City, state, zip code: Sedgwick, Kansas 67016

4. Locate with "X" in section below: Sketch map:

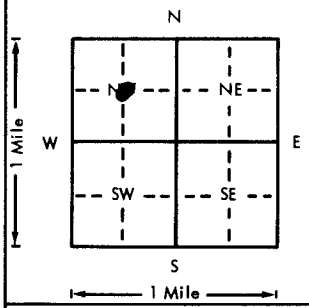

1

6. Bore hole dia. ____ in. Completion date 12-8-75
Well depth 50 ft.

7. __ Cable tool __ Rotary __ Driven __ Dug
__ Hollow rod __ Jetted __ Bored X Reverse rotary

8. Use: __ Domestic __ Public supply __ Industry
X Irrigation __ Air conditioning __ Stock
__ Lawn __ Oil field water __ Other

9. Casing: Material Plastic; Height: Above or below
Threaded ____ Welded ____ Surface 12 in.
RMP ____ PVC X Weight 5 lbs./ft.
Dia. 8 in. to 25 ft. depth; Wall Thickness: inches or
Dia. ____ in. to ____ ft. depth; gage No. 14

5. Type and color of material	From	To
0-2 Soil.		
2-9 Clay.		
9-20 med red sand		
20-40 med " "		
40-50 med. to coarse		

(Use a second sheet if needed)

10. Screen: Manufacturer's name Lawrence.
Type ____ Dia. 8
Slot/gauze 18 Length 25
Set between 25 ft. and 50 ft.
____ ft. and ____ ft.
Gravel pack? X Size range of material 1/8-1/4

11. Static water level: mo./day/yr.
8 ft. below land surface Date 12-10-75

12. Pumping level below land surfaces:
____ ft. after ____ hrs. pumping ____ g.p.m.
____ ft. after ____ hrs. pumping ____ g.p.m.
Estimated maximum yield 800 g.p.m.

13. Water sample submitted: mo./day/yr.
X Yes ____ No Date ____

14. Well head completion:
____ Pitless adapter ____ Inches above grade

15. Well grouted? ____
With: ____ Neat cement X Bentonite ____ Concrete
Depth: From 10 ft. to 10 ft.

16. Nearest source of possible contamination:
ft. ____ Direction ____ Type ____
Well disinfected upon completion? ____ Yes ____ No

17. Pump: ____ Not installed
Manufacturer's name ____
Model number B4TRM HP ____ Volts ____
Length of drop pipe ____ ft. capacity ____ g.p.m.
Type:
____ Submersible ____ Turbine
____ Jet ____ Reciprocating
X Centrifugal ____ Other

18. Elevation:

Topography:
____ Hill
____ Slope
X Upland
____ Valley

19. Remarks:

20. Water well contractor's certification:
This well was drilled under my jurisdiction and this report is true to the best of my knowledge and belief.
Darling Drilling Co. 189
Business name License No.
Address 1211 West 11th Hutchinson, Ks
Signed Donald J Darling Date 12-10-75
Authorized representative

T 25 R 2 (E) (W) Sec 16 1/4 1/4 1/4

Forward the white, blue and pink copies to the Department of Health and Environment

Form WWC-5

MI-1023