USE TYPEWRITER OR BALL POINT PEN-PRESS FIRMLY, PRINT CLEARLY.

WATER WELL RECORD
KSA 82a-1201-1215

Kansas Department of Health and Environment-Division of Environment
(Water well Contractors)
Topeka, Kansas 66620

1. Location of well:	County	Fraction	Section number	Township number	Range number
	Sedgwick	~~NW~~ SW 1/4 NW 1/4 NE 1/4	24	T 25 S	R 2 E (W)

2. Distance and direction from nearest town or city:
Street address of well location if in city: 1 S 1 3/4 E Bentley

3. Owner of well: Leon Black
R.R. or street: Rt. 2
City, state, zip code: Sedgwick, Kansas

4. Locate with "X" in section below:

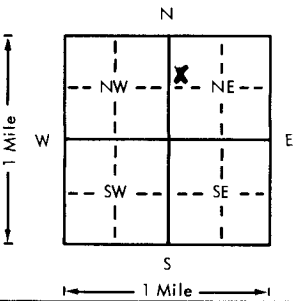

Sketch map: open field

6. Bore hole dia. 30 in. Completion date 7/10/78
Well depth 104 ft.

7. __ Cable tool __ Rotary __ Driven __ Dug
__ Hollow rod __ Jetted __ Bored X Reverse rotary

8. Use: __ Domestic __ Public supply __ Industry
X Irrigation __ Air conditioning __ Stock
__ Lawn __ Oil field water __ Other

9. Casing: Material C-Asb Height: Above or below
Threaded ___ Welded ___ Surface 18 in.
RMP ___ PVC ___ Weight ___ lbs./ft.
Dia. 16 in. to 104 ft. depth Wall Thickness: inches or
Dia. ___ in. to ___ ft. depth gage No. 3/4"

10. Screen: Manufacturer's name Johnson
Type Cement-Asb Dia. 16"
Slot/gauze 1/4" Length 52'
Set between 52 ft. and 104 ft.
___ ft. and ___ ft.
Gravel pack? X Size range of material 3/8

11. Static water level: mo./day/yr.
17 ft. below land surface Date 7/10/78

12. Pumping level below land surfaces:
32 ft. after 2 hrs. pumping 800 g.p.m.
___ ft. after ___ hrs. pumping ___ g.p.m.
Estimated maximum yield 1200 g.p.m.

13. Water sample submitted: mo./day/yr.
__ Yes X No Date ___

14. Well head completion:
__ Pitless adapter 18 Inches above grade

15. Well grouted? X
With: __ Neat cement __ Bentonite X Concrete
Depth: From 0 ft. to 10 ft.

16. Nearest source of possible contamination: None
ft. ___ Direction ___ Type ___
Well disinfected upon completion? ___ Yes X No

17. Pump: __ Not installed
Manufacturer's name Peerless
Model number 8488 HP 40 Volts ___
Length of drop pipe 65 ft. capacity 1200 g.p.m.
Type:
__ Submersible X Turbine
__ Jet __ Reciprocating
__ Centrifugal __ Other

5. Type and color of material	From	To
Topsoil	0	1
Fine Sand	1	10
Clay	10	15
Sand	15	40
Clay - light tan	40	56
Sand	56	67
Clay (heavy gray)	67	78
Sand (Med.)	78	82
Clay (gray)	82	95
Sand (Med.)	95	104

(Use a second sheet if needed)

18. Elevation:

Topography:
__ Hill
__ Slope
X Upland
__ Valley

19. Remarks:

20. Water well contractor's certification:
This well was drilled under my jurisdiction and this report is true to the best of my knowledge and belief.
Weninger Irrigation 238
Business name License No.
Address Haize
Signed K. Weninger Date 8/10/78
Authorized representative

T 25 R 2 E (W) Sec 24 1/4 SW 1/4 NW 1/4 NE

Forward the white, blue and pink copies to the Department of Health and Environment

Form WWC-5

MI-1023