USE TYPEWRITER OR BALL POINT PEN-PRESS FIRMLY, PRINT CLEARLY.

WATER WELL RECORD
KSA 82a-1201-1215

Kansas Department of Health and Environment-Division of Environment
(Water well Contractors)
Topeka, Kansas 66620

1. Location of well:	County	Fraction	Section number	Township number	Range number
	Sedgwick	NE 1/4 1/4 1/4	35	T 25 S	R 2 E/W

2. Distance and direction from nearest town or city: 3 Se of Bentley
Street address of well location if in city: 1 East on corne by milk barn

3. Owner of well: Paul Seiler
R.R. or street: R.R. 1
City, state, zip code: Valley Center, Kansas 67147

4. Locate with "X" in section below:

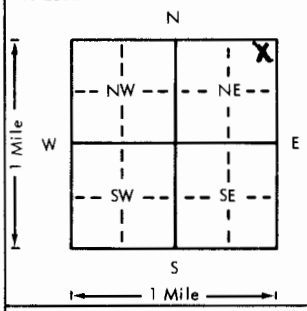

Sketch map:

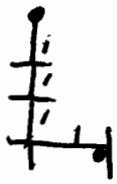

6. Bore hole dia. 10 in. Completion date 5/21/79
Well depth 185 ft.

7. __ Cable tool X Rotary __ Driven __ Dug
__ Hollow rod __ Jetted __ Bored __ Reverse rotary

8. Use: X Domestic __ Public supply __ Industry
__ Irrigation __ Air conditioning __ Stock
__ Lawn __ Oil field water __ Other

9. Casing: Material Plastic Height: Above or below
Threaded ___ Welded ___ Surface 24 in.
RMP ___ PVC X Weight 160 lbs./ft.
Dia. 5 in. to 0 ft. depth Wall Thickness: inches or
Dia. 5 in. to 165 ft. depth gage No. ___

5. Type and color of material	From	To
~~Top soil~~	0	3
~~Clay(brown)~~	3	6
~~Fairly loose red med. sand~~	6	53
~~Med. fine sand w/silk, fairly loose~~	53	87
~~Clay~~	87	125
~~Clay w/some Equis sand~~	125	135
~~Clay~~	135	143
~~Equis sand w/clay~~	143	153
~~Good med. equis sand~~	153	185
~~Fine equis sand~~	185	193
~~Clay~~	193	

(Use a second sheet if needed)

10. Screen: Manufacturer's name Certain teed sawed
Type Sawed Dia. 5"
Slot/gauze 8/16 Length 20
Set between 165 ft. and 185 ft.
___ ft. and ___ ft.
Gravel pack? X Size range of material 1/8 x 1/4

11. Static water level: mo./day/yr.
117 ft. below land surface Date 5-21-79

12. Pumping level below land surfaces:
15 ft. after 1 hrs. pumping 60 g.p.m.
17 ft. after 2 hrs. pumping 80 g.p.m.
Estimated maximum yield 200 g.p.m.

13. Water sample submitted: mo./day/yr.
__ Yes X No Date ___

14. Well head completion:
X Pitless adapter ___ Inches above grade

15. Well grouted? yes
With: ___ Neat cement ___ Bentonite X Concrete
Depth: From 0 ft. to 10 ft.

16. Nearest source of possible contamination:
ft. ___ Direction ___ Type ___
Well disinfected upon completion? X Yes ___ No

17. Pump: X Not installed
Manufacturer's name ___
Model number ___ HP ___ Volts ___
Length of drop pipe ___ ft. capacity ___ g.p.m.
Type:
__ Submersible __ Turbine
__ Jet __ Reciprocating
__ Centrifugal __ Other

18. Elevation:
Topography:
__ Hill
__ Slope
X Upland
__ Valley

19. Remarks:

20. Water well contractor's certification:
This well was drilled under my jurisdiction and this report is true to the best of my knowledge and belief.
Business name Rosencrantz-Bemis Ent. Inc. License No. 134
Address 1211 W. 4th, Hutchinson, Kan.
Signed Donald J. Darby Date 6-1-79
Authorized representative

T 25 R 2 E/W Sec 35 1/4 NE 1/4 NE 1/4 NE 1/4

Forward the white, blue and pink copies to the Department of Health and Environment

Farm WWC-5

MI-1023