


1 LOCATION OF WATER WELL: County: Edwards, Frac.: NW 1/4 NE 1/4 SE 1/4, Section Number: 7, Township Number: T 25 S, Range Number: R 20 EW

Distance and direction from nearest town or city street address of well if located within city?

225' off the NE corner of Kansas Avenue & Elm Street

2 WATER WELL OWNER: Offerle Coop Grain & Supply, P.O. Box 90, Offerle, Ks. 67563, Board of Agriculture, Division of Water Resources, Application Number:

3 LOCATE WELL'S LOCATION WITH AN "X" IN SECTION BOX:

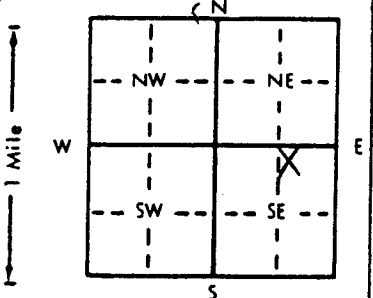

4 DEPTH OF COMPLETED WELL: 51 ft. ELEVATION: 2266.98

Depth(s) Groundwater Encountered, WELL'S STATIC WATER LEVEL: 32.88 ft. below land surface, Pump test data, Bore Hole Diameter: 10 in. to 55 in., WELL WATER TO BE USED AS: 12 Other (Specify below) pump test well

5 TYPE OF BLANK CASING USED: 2 PVC, Blank casing diameter: 2 in. to 31 ft., Casing height above land surface: 0 in., TYPE OF SCREEN OR PERFORATION MATERIAL: 7 PVC, SCREEN OR PERFORATION OPENINGS ARE: 3 Mill slot, SCREEN-PERFORATED INTERVALS: From 31 ft. to 51 ft., GRAVEL PACK INTERVALS: From 29 ft. to 51 ft.

6 GROUT MATERIAL: 2 Cement grout, 3 Bentonite, 4 Other, Grout Intervals: From 0 ft. to 29 ft., From 29 ft. to 31 ft., What is the nearest source of possible contamination: 11 Fuel storage, Direction from well? south, How many feet? 10

LITHOLOGIC LOG table with columns FROM, TO, LITHOLOGIC LOG, FROM, TO, PLUGGING INTERVALS. Rows include 0-6" roadgravel, 6"-7" silt, brn, clayey, 7"-10" silt, lt green (olv) clayey, 10"-20" clay, lt green (olv) silty, 20"-55" clay, lt brn-tan, silty

7 CONTRACTOR'S OR LANDOWNER'S CERTIFICATION: This water well was (1) constructed, (2) reconstructed, or (3) plugged under my jurisdiction and was completed on (mo/day/year) 03-15-94 and this record is true to the best of my knowledge and belief. Kansas Water Well Contractor's License No. 527, This Water Well Record was completed on (mo/day/yr) 04-27-94 under the business name of GedCore Services, Inc. by (signature) Dale Pohl