


MW-8

1 LOCATION OF WATER WELL: County: Edwards Fraction: NE 1/4 NW 1/4 SE 1/4 Section Number: 7 Township Number: T 25 S Range Number: R 20 EW

Distance and direction from nearest town or city street address of well if located within city?
SE of Elm & Kansas Ave

2 WATER WELL OWNER: Offerle Coop Grain & Supply Co.
 RR#, St. Address, Box #: Box 65 Board of Agriculture, Division of Water Resources
 City, State, ZIP Code: Offerle KS 67563 Application Number:

3 LOCATE WELL'S LOCATION WITH AN "X" IN SECTION BOX:

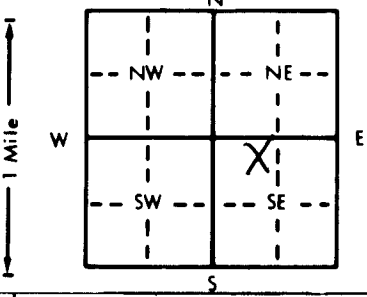

4 DEPTH OF COMPLETED WELL: 47.0 ft. ELEVATION: NA
 Depth(s) Groundwater Encountered 1. NA ft. 2. _____ ft. 3. _____ ft.
 WELL'S STATIC WATER LEVEL: NA ft. below land surface measured on mo/day/yr NA
 Pump test data: Well water was _____ ft. after _____ hours pumping _____ gpm
 Est. Yield _____ gpm; Well water was _____ ft. after _____ hours pumping _____ gpm
 Bore Hole Diameter: 8 in. to _____ ft., and _____ in. to _____ ft.
 WELL WATER TO BE USED AS:
 5 Public water supply 8 Air conditioning 11 Injection well
 1 Domestic 3 Feedlot 6 Oil field water supply 9 Dewatering 12 Other (Specify below)
 2 Irrigation 4 Industrial 7 Lawn and garden only 10 Monitoring well
 Was a chemical/bacteriological sample submitted to Department? Yes _____ No X; If yes, mo/day/yr sample was submitted _____
 Water Well Disinfected? Yes _____ No X

5 TYPE OF BLANK CASING USED:
 1 Steel 3 RMP (SR) 5 Wrought iron 8 Concrete tile CASING JOINTS: Glued _____ Clamped _____
2 PVC 4 ABS 7 Fiberglass _____ Welded _____
 Blank casing diameter _____ in. to _____ ft., Dia _____ in. to _____ ft., Dia _____ in. to _____ ft.
 Casing height above land surface: Flush in., weight _____ lbs./ft. Wall thickness or gauge No. 154
 TYPE OF SCREEN OR PERFORATION MATERIAL:
 1 Steel 3 Stainless steel 5 Fiberglass 8 RMP (SR) 10 Asbestos-cement
 2 Brass 4 Galvanized steel 6 Concrete tile 9 ABS 11 Other (specify) _____
 12 None used (open hole)
 SCREEN OR PERFORATION OPENINGS ARE:
 1 Continuous slot 3 Mill slot 5 Gauzed wrapped 8 Saw cut 11 None (open hole)
 2 Louvered shutter 4 Key punched 6 Wire wrapped 9 Drilled holes
 7 Torch cut 10 Other (specify) _____
 SCREEN-PERFORATED INTERVALS: From 31.8 ft. to 46.8 ft., From _____ ft. to _____ ft.
 GRAVEL PACK INTERVALS: From 30.8 ft. to 46.8 ft., From _____ ft. to _____ ft.

6 GROUT MATERIAL: 1 Neat cement 2 Cement grout 3 Bentonite 4 Other _____
 Grout Intervals: From 30.8 ft. to 1.0 ft., From _____ ft. to _____ ft.
 What is the nearest source of possible contamination:
 1 Septic tank 4 Lateral lines 7 Pit privy 11 Fuel storage 14 Abandoned water well
 2 Sewer lines 5 Cess pool 8 Sewage lagoon 12 Fertilizer storage 15 Oil well/Gas well
 3 Watertight sewer lines 6 Seepage pit 9 Feedyard 13 Insecticide storage 16 Other (specify below) _____
 Direction from well? NA How many feet? NA

| FROM | TO | LITHOLOGIC LOG | FROM | TO | PLUGGING INTERVALS |
|---|------|-------------------|------|----|--------------------|
| 0.0 | 10.0 | Clay, silty | | | |
| 10.0 | 15.0 | Silt, very clayey | | | |
| 15.0 | 20.0 | Clay, silty | | | |
| 20.0 | 25.0 | Silt, clayey | | | |
| 25.0 | 47.0 | Silt, very moist | | | |
| <p>Flush mount waiver granted on 10-13-92 for KDHE NO. 01024048B, Offerle Coop Grain & Supply by Don Taylor</p> | | | | | |

7 CONTRACTOR'S OR LANDOWNER'S CERTIFICATION: This water well was (1) constructed, (2) reconstructed, or (3) plugged under my jurisdiction and was completed on (mo/day/year) 11-3-92 and this record is true to the best of my knowledge and belief. Kansas Water Well Contractor's License No. 531 This Water Well Record was completed on (mo/day/yr) 11-10-92 under the business name of Geotechnical Services, Inc by (signature) Allison Irwin

OFFICE USE ONLY T R EM SEC 1/4 1/4 1/4