


1 LOCATION OF WATER WELL: Fraction NW 1/4 NE 1/4 SE 1/4 Section Number 7 Township Number T 25 S Range Number R 20 W  
 County: Edwards

Distance and direction from nearest town or city street address of well if located within city?  
150' of the NE corner of Kansas Avenue & Elm Street

2 WATER WELL OWNER: Offire Coop Grain & Supply  
 RR #, St. Address, Box #: P.O. Box 90 Board of Agriculture, Division of Water Resources  
 City, State, ZIP Code: Offire, Kansas 67563 Application Number: \_\_\_\_\_

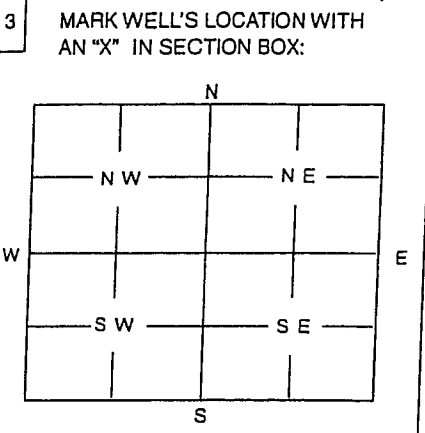

4 DEPTH OF WELL ..... 34 ..... ft  
 WELL'S STATIC WATER LEVEL ..... NA ..... ft  
 WELL WAS USED AS:  
 1 Domestic                      5 Public Water Supply                      9 Dewatering  
 2 Irrigation                      6 Oil Field Water Supply                      10 Monitoring Well  
 3 Feedlot                      7 Domestic (Lawn & Garden)                      11 Injection Well  
 4 Industrial                      8 Air Conditioning                      12 Other vapor extraction

Was a chemical / bacteriological sample submitted to Department? Yes ..... No  .....  
 If yes, mo/day/yr sample was submitted .....

Water Well Disinfected: Yes ..... No  .....

5 TYPE OF BLANK CASING USED:  
 1 Steel      3 RMP (SR)      5 Wrought      7 Fiberglass      9 Other (Specify below)  
 2 PVC      4 ABS      6 Asbestos-Cement      8 Concrete Tile

Blank casing diameter 2 in.      Was casing pulled?      Yes ..... No  .....      If yes, how much .....

Casing height above or below land surface 0 in.

6 GROUT PLUG MATERIAL:      1 Neat cement      2 Cement grout      3 Bentonite      4 Other Sand + Gravel

Grout Plug Intervals:      From 5 ft. to 34 ft.,      From 0 ft. to 5 ft.,      From ..... to ..... ft.

What is the nearest source of possible contamination:  
 1 Septic tank                      6 Seepage pit                      11 Fuel storage                      16 Other (specify below)  
 2 Sewer lines                      7 Pit privy                      12 Fertilizer storage  
 3 Watertight sewer lines                      8 Sewage lagoon                      13 Insecticide storage  
 4 Lateral lines                      9 Feedyard                      14 Abandoned water well  
 5 Cess Pool                      10 Livestock pens                      15 Oil well/Gas well

Direction from well? east                      How many feet? 265

FROM	TO	PLUGGING MATERIALS
<u>0</u>	<u>5</u>	<u>Sand + Gravel</u>
<u>5</u>	<u>5</u>	<u>Bentonite (8")</u>
<u>5</u>	<u>34</u>	<u>Bentonite (2")</u>

V08W1

7 CONTRACTOR'S OR LANDOWNER'S CERTIFICATION: This water well was plugged under my jurisdiction and was completed on (mo/day/year) 11/14/00 and this record is true to the best of my knowledge and belief. Kansas Water Well Contractor's License No. 527 This Water Well Record was completed on (mo/day/year) 12/1/00 under the business name of Geo. Coca Services, Inc. by (signature) Dale L. L...

INSTRUCTIONS: Use typewriter or ball point pen. Please press firmly and print clearly. Please fill in blanks, underline or circle the correct answers. Send top three copies to Kansas Department of Health and Environment, Bureau of Water, Topeka, Kansas 66620-0001. Telephone: 785/296-3565. Send one to Water Well Owner and retain one for your records.