


1	LOCATION OF WATER WELL:	Fraction	Section Number	Township Number	Range Number
	County: <u>Edwards</u>	<u>NW 1/4 NE 1/4 SE 1/4</u>	<u>7</u>	<u>T 25 S</u>	<u>R 20 W</u>

Distance and direction from nearest town or city street address of well if located within city?
155' off the NE corner of Kansas Avenue & Elm Street

2	WATER WELL OWNER: <u>Offerle Coop Grain & Supply</u>	Board of Agriculture, Division of Water Resources
	RR #, St. Address, Box #: <u>P.O. Box 90</u>	Application Number:
	City, State, ZIP Code: <u>Offerle, Kansas 67563</u>	

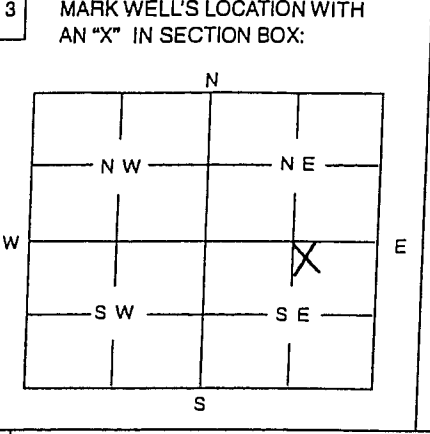

4	DEPTH OF WELL <u>34</u> ft												
	WELL'S STATIC WATER LEVEL ... <u>NA</u> ft.												
	WELL WAS USED AS:												
	<table border="0"> <tr> <td>1 Domestic</td> <td>5 Public Water Supply</td> <td>9 Dewatering</td> </tr> <tr> <td>2 Irrigation</td> <td>6 Oil Field Water Supply</td> <td>10 Monitoring Well</td> </tr> <tr> <td>3 Feedlot</td> <td>7 Domestic (Lawn & Garden)</td> <td>11 Injection Well</td> </tr> <tr> <td>4 Industrial</td> <td>8 Air Conditioning</td> <td>12 Other <u>vapor extraction</u></td> </tr>
	Was a chemical / bacteriological sample submitted to Department? Yes No <input checked="" type="checkbox"/>												
	If yes, mo/day/yr sample was submitted												
	Water Well Disinfected: Yes No <input checked="" type="checkbox"/>												

5 TYPE OF BLANK CASING USED:

1 Steel	3 RMP (SR)	5 Wrought	7 Fiberglass	9 Other (Specify below)
2 PVC	4 ABS	6 Asbestos-Cement	8 Concrete Tile	

Blank casing diameter 2 in. Was casing pulled? Yes No If yes, how much

Casing height above or below land surface 0 in.

6 GROUT PLUG MATERIAL: 1 Neat cement 2 Cement grout 3 Bentonite 4 Other Sand + Gravel

Grout Plug Intervals: From 5 ft. to 34 ft., From 0 ft. to 5 ft., From to ft.

What is the nearest source of possible contamination:

1 Septic tank	6 Seepage pit	11 Fuel storage	16 Other (specify below)
2 Sewer lines	7 Pit privy	12 Fertilizer storage	
3 Watertight sewer lines	8 Sewage lagoon	13 Insecticide storage	
4 Lateral lines	9 Feedyard	14 Abandoned water well	
5 Cess Pool	10 Livestock pens	15 Oil well/Gas well	

Direction from well? Southeast How many feet? 267

FROM	TO	PLUGGING MATERIALS
<u>0</u>	<u>5</u>	<u>Sand + Gravel</u>
<u>.5</u>	<u>5</u>	<u>Bentonite (8")</u>
<u>5</u>	<u>34</u>	<u>Bentonite (2")</u>

VOBW 2

7 CONTRACTOR'S OR LANDOWNER'S CERTIFICATION: This water well was plugged under my jurisdiction and was completed on (mo/day/year) 11/14/00 and this record is true to the best of my knowledge and belief. Kansas Water Well Contractor's License No. 527 This Water Well Record was completed on (mo/day/year) 12/1/00 under the business name of Be Care Services, Inc by (signature) [Signature]

INSTRUCTIONS: Use typewriter or ball point pen. Please press firmly and print clearly. Please fill in blanks, underline or circle the correct answers. Send top three copies to Kansas Department of Health and Environment, Bureau of Water, Topeka, Kansas 66620-0001. Telephone: 785/296-3565. Send one to Water Well Operator and retain one for your records.