


1 LOCATION OF WATER WELL:	Fraction	Section Number	Township Number	Range Number
County: <u>Edwards</u>	<u>NW 1/4 NE 1/4 SE 1/4</u>	<u>7</u>	<u>T 25 S</u>	<u>R 20 W</u>

Distance and direction from nearest town or city street address of well if located within city?
145' off the NE corner of Kansas Avenue & Elm Street

2 WATER WELL OWNER: Offerle Coop Grain & Supply
 RR #, St. Address, Box #: P.O. Box 90
 City, State, ZIP Code: Offerle, Kansas 67563
 Board of Agriculture, Division of Water Resources
 Application Number: _____

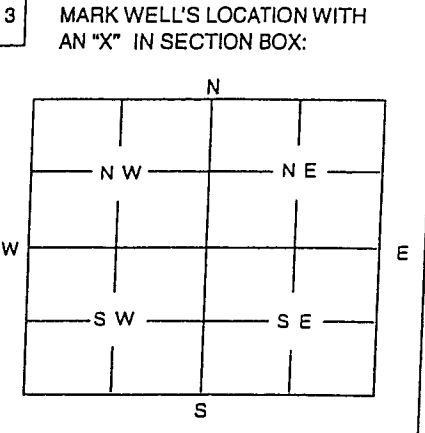

4 DEPTH OF WELL 34 ft
 WELL'S STATIC WATER LEVEL NA ft

WELL WAS USED AS:

1 Domestic	5 Public Water Supply	9 Dewatering
2 Irrigation	6 Oil Field Water Supply	10 Monitoring Well
3 Feedlot	7 Domestic (Lawn & Garden)	11 Injection Well
4 Industrial	8 Air Conditioning	12 Other <u>sewer extraction</u>

Was a chemical / bacteriological sample submitted to Department? Yes No
 If yes, mo/day/yr sample was submitted

Water Well Disinfected: Yes No

5 TYPE OF BLANK CASING USED:

1 Steel	3 RMP (SR)	5 Wrought	7 Fiberglass	9 Other (Specify below)
2 PVC	4 ABS	6 Asbestos-Cement	8 Concrete Tile	

Blank casing diameter 2 in. Was casing pulled? Yes No
 Casing height above or below land surface 0 in. If yes, how much

6 GROUT PLUG MATERIAL: 1 Neat cement 2 Cement grout 3 Bentonite 4 Other Sand & Gravel

Grout Plug Intervals: From 5 ft. to 34 ft., From 0 ft. to 5 ft., From to ft.

What is the nearest source of possible contamination:

1 Septic tank	6 Seepage pit	11 Fuel storage	16 Other (specify below)
2 Sewer lines	7 Pit privy	12 Fertilizer storage	
3 Watertight sewer lines	8 Sewage lagoon	13 Insecticide storage	
4 Lateral lines	9 Feedyard	14 Abandoned water well	
5 Cess Pool	10 Livestock pens	15 Oil well/Gas well	

Direction from well? northeast How many feet? 270

FROM	TO	PLUGGING MATERIALS
<u>0</u>	<u>.5</u>	<u>Sand & Gravel</u>
<u>.5</u>	<u>5</u>	<u>Bentonite (8")</u>
<u>5</u>	<u>34</u>	<u>Bentonite (2")</u>

VOBW 3

7 CONTRACTOR'S OR LANDOWNER'S CERTIFICATION: This water well was plugged under my jurisdiction and was completed on (mo/day/year) 11/14/00 and this record is true to the best of my knowledge and belief. Kansas Water Well Contractor's License No. 527 This Water Well Record was completed on (mo/day/year) 12/1/00
 by (signature) [Signature] under the business name of Geolac Services, Inc.

INSTRUCTIONS: Use typewriter or ball point pen. Please press firmly and print clearly. Please fill in blanks, underline or circle the correct answers. Send top three copies to Kansas Department of Health and Environment, Bureau of Water, Topeka, Kansas 66620-0001. Telephone: 785/296-3565. Send one to Water Well Owner and retain one for your records.