
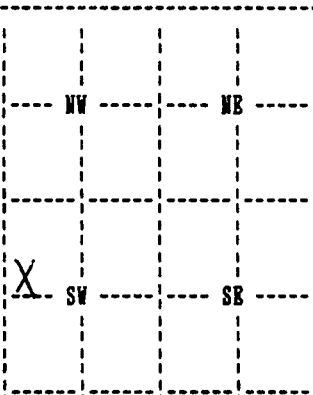


1 LOCATION OF WATER WELL: Fraction Section Number Township Number Range Number
 COUNTY: EDWARDS SW 1/4 NW 1/4 SW 1/4 8 T 25 S R 20 ~~E~~ 

Distance and direction from nearest town or city street address of well if located within city?
 FROM OPPELLE - 1/2 E ON HIGHWAY 50 & 1/4 SOUTH

2 WATER WELL OWNER: BUTLER, LEONA M.
 RR#, St. Address, Box #: RR #1 Board of Agriculture, Division of Water Resources
 City, State, ZIP code: OPPELLE, KS 67563- Application Number:

3 LOCATE WELL'S LOCATION WITH AN "X" IN SECTION BOX:		4 DEPTH OF COMPLETED WELL 118 ELEVATION: 0	
		Depth(s) Groundwater Encountered 1. 0 ft. 2. 0 ft. 3. 0 ft.	
		WELL'S STATIC WATER LEVEL 41 ft. below land surface measured on mo/day/yr 11/11/05	
		Pump test data: Well water was 0 ft. after 0 hours pumping 0 gpm	
		Estimated Yield 40 gpm: Well water was 0 ft. after 0 hours pumping 0 gpm	
		Bore Hole Diameter 10 in. to 118 ft., and in. to 0 ft.	
		WELL WATER TO BE USED AS: DOMESTIC	
		Was a chemical/bacteriological sample submitted to department? No ;	
		If yes, mo/day/yr sample was submitted Water well disinfected? Yes	

5 TYPE OF BLANK CASING USED: PVC CASING JOINTS: GLUED
 Blank casing diameter 5 in. to 118 ft., Dia in. to 0 ft., Dia in. to 0 ft.
 Casing height above land surface 12 in., weight 200 lbs/ft. Wall thickness or gauge No. 21
 TYPE OF SCREEN OR PERFORATION MATERIAL: PVC
 SCREEN OR PERFORATION OPENINGS ARE: SAW CUT

SCREEN PERFORATED INTERVALS: From 94 ft. to 114 ft., From 0 ft. to 0 ft.
 From 0 ft. to 0 ft., From 0 ft. to 0 ft.
 GRAVEL PACK INTERVALS: From 20 ft. to 118 ft., From 0 ft. to 0 ft.
 From 0 ft. to 0 ft., From 0 ft. to 0 ft.

6 GROUT MATERIAL BENTONITE
 Grout Intervals: From 0 ft. to 20 ft., From 0 ft. to 0 ft., From 0 ft. to 0 ft.
 What is the nearest source of possible contamination: NONE
 Direction from well? How many feet? 0

FROM	TO	LITHOLOGIC LOG	FROM	TO	PLUGGING INTERVALS
0	20	01 TOPSOIL 32 TAN CLAY			
20	60	32 TAN CLAY			
60	80	32 TAN CLAY 35 CALACHIE 24 THINROCLAYER			
80	100	32 TAN CLAY 37 FIN-COAR SAN			
100	110	37 FIN-COAR SAN			
110	130	16 GRAY CLAY			
130	140	16 GRAY CLAY 07 BLUE SHALE			

7 CONTRACTOR'S OR LANDOWNER'S CERTIFICATION: This water well was Constructed under my jurisdiction and was completed on (mo/day/year) 11/12/05 and this record is true to the best of my knowledge and belief. Kansas Water Well Contractor's License No. 179 This Water Well Record was completed on (mo/day/yr) 11/28/05 under the business name of JOE'S WELL SERVICE, INC. by (signature) *Judith Cirt*