


1 LOCATION OF WATER WELL: Fraction SW 1/4 SW 1/4 SW 1/4 Section Number 1 Township Number T 25 S Range Number R 21 **(EW)**
 County: FORD

Distance and direction from nearest town or city street address of well if located within city?
3 1/2 East, 1 North of Belfont, Kansas

2 WATER WELL OWNER: Mr. Rean Stegman
 RR#, St. Address, Box # : Route #1
 City, State, ZIP Code : Offerle, KS 67563
 Board of Agriculture, Division of Water Resources
 Application Number: ---

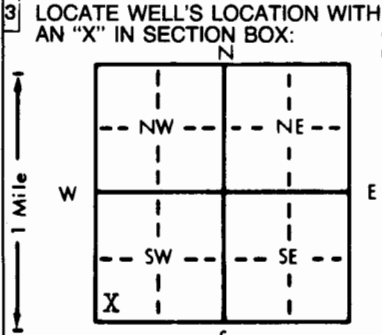

4 DEPTH OF COMPLETED WELL: 110 ft. ELEVATION: Slope
 Depth(s) Groundwater Encountered 1. Not available ft. 2. --- ft. 3. --- ft.
 WELL'S STATIC WATER LEVEL 41 ft. below land surface measured on mo/day/yr Dec. 16, 1988
 Pump test data: Well water was --- ft. after --- hours pumping --- gpm
 Est. Yield 20 gpm: Well water was --- ft. after --- hours pumping --- gpm
 Bore Hole Diameter 10 in. to 110 ft., and --- in. to --- ft.
 WELL WATER TO BE USED AS:
 Domestic 3 Feedlot 6 Oil field water supply 9 Dewatering 12 Other (Specify below)
 2 Irrigation 4 Industrial 7 Lawn and garden only 10 Monitoring well
 Was a chemical/bacteriological sample submitted to Department? Yes --- No XX; If yes, mo/day/yr sample was submitted
 Water Well Disinfected? Yes XX No ---

5 TYPE OF BLANK CASING USED:
 1 Steel 3 RMP (SR) 5 Wrought iron 8 Concrete tile CASING JOINTS: Glued XX Clamped ---
 2 PVC 4 ABS 6 Asbestos-Cement 9 Other (specify below) Welded ---
 7 Fiberglass Threaded ---
 Blank casing diameter 5 in. to 70 ft., Dia --- in. to --- ft., Dia --- in. to --- ft.
 Casing height above land surface 18 in., weight 2.8 lbs./ft. Wall thickness or gauge No. 265
 TYPE OF SCREEN OR PERFORATION MATERIAL:
 1 Steel 3 Stainless steel 5 Fiberglass 8 RMP (SR) 10 Asbestos-cement
 2 Brass 4 Galvanized steel 6 Concrete tile 9 ABS 11 Other (specify) ---
 12 None used (open hole)
 SCREEN OR PERFORATION OPENINGS ARE:
 1 Continuous slot 3 Mill slot 5 Gauzed wrapped 9 Saw cut 11 None (open hole)
 2 Louvered shutter 4 Key punched 6 Wire wrapped 9 Drilled holes
 7 Torch cut 10 Other (specify) ---
 SCREEN-PERFORATED INTERVALS: From 70 ft. to 110 ft., From --- ft. to --- ft.
 From --- ft. to --- ft., From --- ft. to --- ft.
 GRAVEL PACK INTERVALS: From 20 ft. to 110 ft., From --- ft. to --- ft.
 From --- ft. to --- ft., From --- ft. to --- ft.

6 GROUT MATERIAL: 1 Neat cement 2 Cement grout 3 Bentonite Other Baroid Hole Plug
 Grout Intervals: From 0 ft. to 20 ft., From --- ft. to --- ft., From --- ft. to --- ft.
 What is the nearest source of possible contamination:
 1 Septic tank 4 Lateral lines 7 Pit privy 10 Livestock pens 14 Abandoned water well
 2 Sewer lines 5 Cess pool 8 Sewage lagoon 11 Fuel storage 15 Oil well/Gas well
 3 Watertight sewer lines 6 Seepage pit 9 Feedyard 12 Fertilizer storage 16 Other (specify below)
 13 Insecticide storage
 Direction from well? East How many feet? 150

FROM	TO	LITHOLOGIC LOG	FROM	TO	PLUGGING INTERVALS
0	2	Topsoil			
2	61	Clay			
61	72	Caliche			
72	94	Med. Gravel			
94	101	Clay			
101	105	Med. Gravel			
105	110	Clay			

7 CONTRACTOR'S OR LANDOWNER'S CERTIFICATION: This water well was (1) constructed, (2) reconstructed, or (3) plugged under my jurisdiction and was completed on (mo/day/year) Dec. 16, 1988 and this record is true to the best of my knowledge and belief. Kansas Water Well Contractor's License No. 252 This Water Well Record was completed on (mo/day/yr) Dec. 28, 1988 under the business name of FRIESEN WINDMILL & SUPPLY INC. by (signature) [Signature]

INSTRUCTIONS: Use typewriter or ball point pen. PLEASE PRESS FIRMLY and PRINT clearly. Please fill in blanks, underline or circle the correct answers. Send top three copies to Kansas Department of Health and Environment, Bureau of Water Protection, Topeka, Kansas 66620-7320. Telephone: 913-296-5514. Send one to WATER WELL OWNER and retain one for your records.

07-880000088-40