

USE TYPEWRITER OR BALL POINT PEN-PRESS FIRMLY, PRINT CLEARLY.

WATER WELL RECORD
KSA 82a-1201-1215

T R EW sec 1/4 1/4 1/4 No.


Kansas State Dept. Of Health
(Water Well Contractors)
Forbes-Bldg. 740
Topeka, Kansas 66620

OFFERLE SE

BAA

1 Location of well:	County Ford	Township name Wheatland	From NE1/4 of NW1/4 WENEW	Section number 22	Town number T-25-S	Range number R-21-W
---------------------	-----------------------	-----------------------------------	--	-----------------------------	------------------------------	-------------------------------

Distance and direction from nearest town or city: 2 mi. east of Bellefont, Ks Street address of well location if in city:	3 Owner of well: B ob Overstreet Address: Offerle, Kansas
--	--

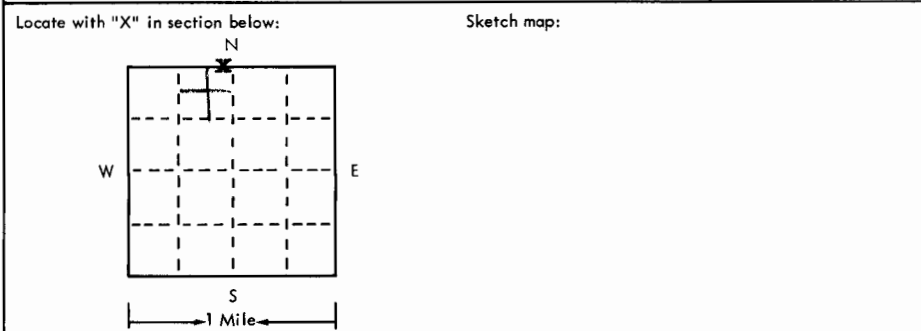

4 Well depth: 207 ft. Date of completion 8-20-75 Well diameter 28 in.
5 <input type="checkbox"/> Cable tool <input type="checkbox"/> Rotary <input type="checkbox"/> Driven <input type="checkbox"/> Dug <input type="checkbox"/> Hollow rod <input type="checkbox"/> Jetted <input type="checkbox"/> Bored <input checked="" type="checkbox"/> Reverse rotary
6 Use: <input type="checkbox"/> Domestic <input type="checkbox"/> Public supply <input type="checkbox"/> Industry <input checked="" type="checkbox"/> Irrigation <input type="checkbox"/> Air conditioning <input type="checkbox"/> Commercial <input type="checkbox"/> Test well
7 Casing: Material <u>Metal</u> Height: above/below Threaded <input type="checkbox"/> Welded <input checked="" type="checkbox"/> Surface 12 in. Diam. 30.30 in. Weight 30.30 lb./ft. 16 in. to 207 ft. depth! Drive shoe? <input type="checkbox"/> Yes <input checked="" type="checkbox"/> No ___ in. to ___ ft. depth!

2	Type and color of material	From	To
	Brown clay	0	10
	Light brown and caleche clay	10	65
	A-1 tan and brown sandstone with 5% clay	65	95
	Sandstone	95	123
	Extra hard rock with sandstone	123	126
	Gray shale	126	131
	Gray sandstone with 10 to 15% shale	131	139
	Gray shale	139	155
	Tan sandstone with 10% shale	155	163
	Gray shale with rock layers	163	181
	Brown sandrock grit with 35% clay	181	185
	Tan sandstone	185	204
	Red and gray shale	204	240
	BRICK ~ 48'		
	(use a second sheet if needed)		

8 Screen: Manufacturer W.A. Brown and Cook Type Free-flo Dia. 16" Slot/gauze 5/16" 1/8" 2" Set between 179 ft. and 204 ft. Fittings: Cook from 194 to 204 Gravel pack <input type="checkbox"/> Yes <input type="checkbox"/> No Size range of material 1/4"
9 Static water level: 53 ft. below land surface Date 8-20-75
10 Pumping level below land surfaces: 190 ft. after 4 hrs. pumping 500 g.p.m. ___ ft. after ___ hrs. pumping ___ g.p.m. Estimated maximum yield 500 g.p.m.
11 Water sample submitted: <input type="checkbox"/> Yes <input checked="" type="checkbox"/> No Date ___
12 Well head completion: <input type="checkbox"/> Pitless adapter <input checked="" type="checkbox"/> Inches above grade
13 Well grouted? <input checked="" type="checkbox"/> Yes <input type="checkbox"/> No <input type="checkbox"/> Neat cement <input type="checkbox"/> Bentonite <input type="checkbox"/> ___ Depth: From 0 ft. to 10 ft.
14 Nearest source of possible contamination: NA ft. ___ Direction ___ Type ___ Well disinfected upon completion? <input type="checkbox"/> Yes <input checked="" type="checkbox"/> No
15 Pump: <input checked="" type="checkbox"/> Not installed Manufacturer's name ___ Model number ___ HP ___ Volts ___ Length of drop pipe ___ ft. capacity ___ g.p.p. Type: <input type="checkbox"/> Submersible <input type="checkbox"/> Turbine <input type="checkbox"/> Jet <input type="checkbox"/> Reciprocating <input type="checkbox"/> Centrifugal <input type="checkbox"/> Other

16 Remarks: elevation

Topography:
 Hill
 Slope
 Upland
 Valley

TOPO

17 Water well contractor's certification:
This well was drilled under my jurisdiction and this report is true to the best of my knowledge and belief.

Ace-Hi International Inc. 190

Business name License No.
Address **Box 1442, Dodge City, Ks**
Signed **Carl C. ...** Date **8-22-75**
Authorized representative

2322
48
2274